

**AS-BUILT SURVEY OF: ADMIRALS QUARTERS CONDO**

**3.9 ACRES +/- SEC. 9, T-9-S, R-9-E**

**ADMIRALS QUARTERS ASSOCIATES, LLC.**

**HUTCHINSON, MOORE & RAUCH, LLC**

**ENGINEERS-SURVEYORS**

**FOLLY, ALABAMA**

**111 WEST WATKINS AVE., SUITE 1**

**POST OFFICE BOX 1072**

**36538**

**TEL (334) 870-2422**

**FAX (334) 870-2425**

**hmr@hmrllc.com**

**NOTES:**

1. ALL DIMENSIONS ARE IN FEET AND INCHES. DIMENSIONS ARE GIVEN TO THE CENTER OF THE LINE UNLESS OTHERWISE NOTED.
2. ALL DIMENSIONS ARE TO THE CENTER OF THE LINE UNLESS OTHERWISE NOTED.
3. ALL DIMENSIONS ARE TO THE CENTER OF THE LINE UNLESS OTHERWISE NOTED.
4. ALL DIMENSIONS ARE TO THE CENTER OF THE LINE UNLESS OTHERWISE NOTED.
5. ALL DIMENSIONS ARE TO THE CENTER OF THE LINE UNLESS OTHERWISE NOTED.
6. ALL DIMENSIONS ARE TO THE CENTER OF THE LINE UNLESS OTHERWISE NOTED.
7. ALL DIMENSIONS ARE TO THE CENTER OF THE LINE UNLESS OTHERWISE NOTED.
8. ALL DIMENSIONS ARE TO THE CENTER OF THE LINE UNLESS OTHERWISE NOTED.
9. ALL DIMENSIONS ARE TO THE CENTER OF THE LINE UNLESS OTHERWISE NOTED.
10. ALL DIMENSIONS ARE TO THE CENTER OF THE LINE UNLESS OTHERWISE NOTED.

**ARCHITECTURE  
&  
ENVIRONMENTAL  
DESIGN**

(BSU) 432-6011  
FAX 435-9001

JOB NO.: 079241  
CAD: PEGIL  
CHECKED IN  
DATE: 4/4/91  
REVISION:

1

9

THE UNDERSIGNED, HENRY NORRIS, A REGISTERED ARCHITECT  
IN THE STATE OF ALABAMA, REGISTRATION NUMBER 2665,  
PURSUANT TO SECTION 35-8A-209, CODE OF ALABAMA, 1975,  
HEREBY CERTIFIES THAT TO THE BEST OF HIS KNOWLEDGE,  
DRAWINGS CONSISTING OF PAGES 1 THROUGH 15 INCLUSIVE,  
ATTACHED TO AND MADE PART OF THE DECLARATION OF  
CONDOMINIUM OF ADMIRALS QUARTERS, A CONDOMINIUM,  
CONTAINS ALL INFORMATION REQUIRED BY SAID SECTION,  
FULLY AND ACCURATELY REFLECT THE LAYOUT, LOCATIONS, UNIT  
NUMBERS, AND INTERESTS OF SAID CONDOMINIUM. THE UNDERSIGNED  
TO IDENTIFY THE COMMON ELEMENTS AND TO PROVIDE DETAIL  
ADMIRALS QUARTERS CONDOMINIUM, AS BUILT.

*D. d. L.*

ALABAMA REGISTRATION NUMBER 2665

DATE *4/6/01*

ALABAMA REGISTRATION NUMBER 26655


4/22/01  
DATE

105 LIMITED COMMON ELEMENT PARKING SPACES  
95 COMMON ELEMENT PARKING SPACES  
200 PARKING SPACES TOTAL

**SITE PLAN**  
**1"=30'-0"**

**GULF OF MEXICO**

**(C) HENRY NORRIS & ASSOCIATES, INC.**

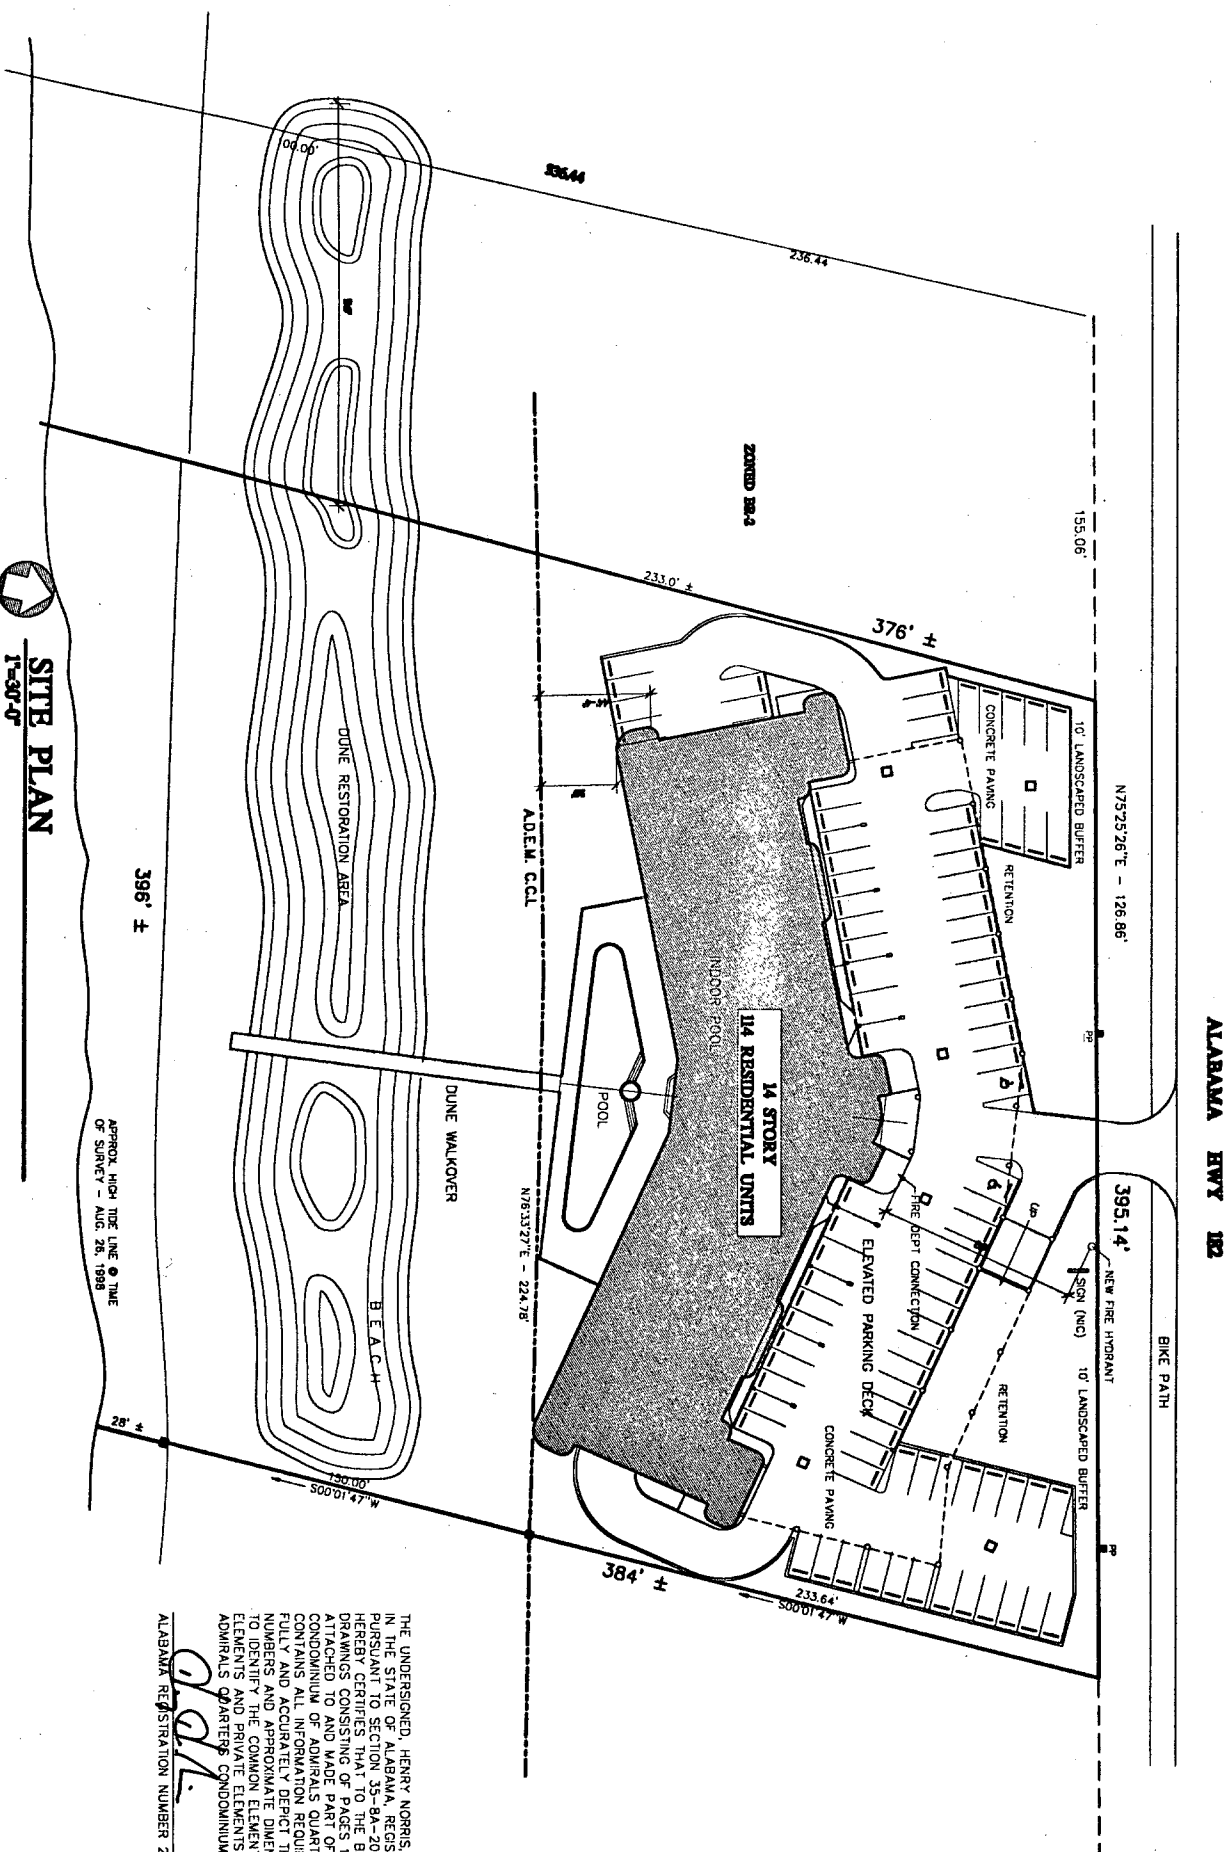

4/13/01  
DATE

NOTE:  
NUMBERED PARKING SPACES ARE  
LIMITED COMMON ELEMENTS.




**(850) 432-6011**  
**FAX 435-9001**

**ADMIRAL'S QUARTERS**  
**ORANGE BEACH, ALABAMA**

JOB NO.: 093811  
CAG: mgll  
CHECKED IN  
DATE 4/4/01  
REVISION:

## SUMMARY

2

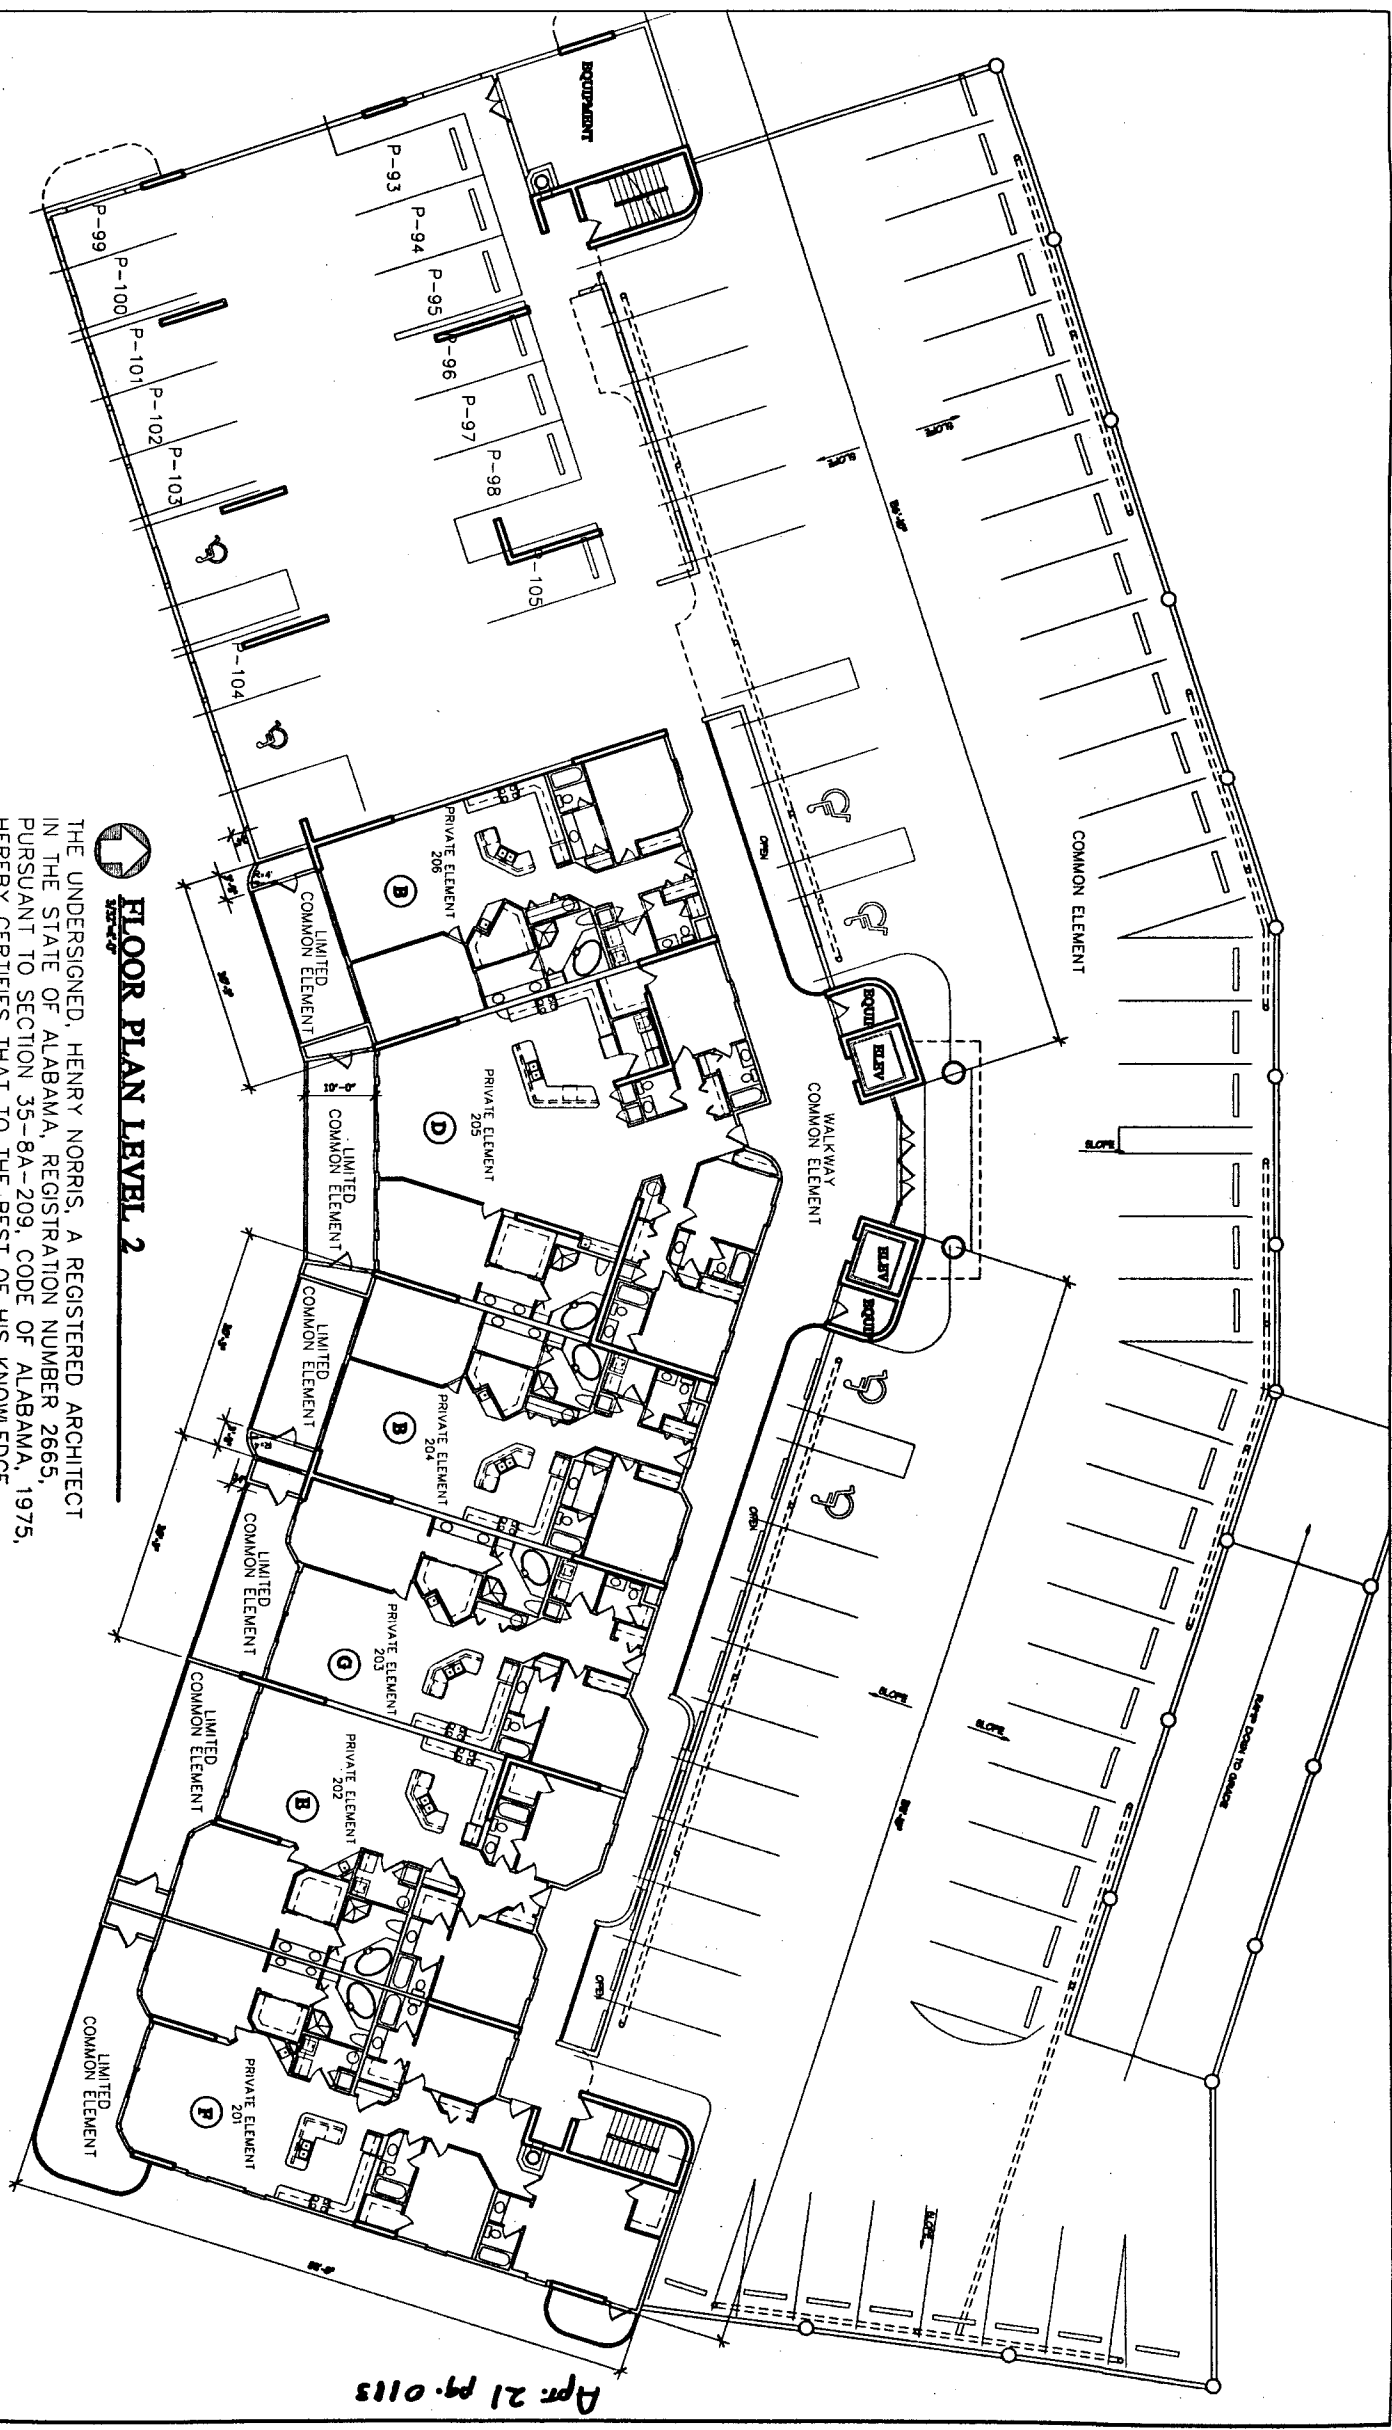

**FLOOR PLAN LEVEL 2**

THE UNDERSIGNED, HENRY NORRIS, A REGISTERED ARCHITECT IN THE STATE OF ALABAMA, REGISTRATION NUMBER 2665, PURSUANT TO SECTION 35-8A-209, CODE OF ALABAMA, 1975, HEREBY CERTIFIES THAT TO THE BEST OF HIS KNOWLEDGE, DRAWINGS CONSISTING OF PAGES 1 THROUGH 15 INCLUSIVE, ATTACHED TO AND MADE PART OF THE DECLARATION OF CONDOMINIUM OF ADMIRALS QUARTERS, A CONDOMINIUM, CONTAINS ALL INFORMATION REQUIRED BY SAID SECTION, FULLY AND ACCURATELY DEPICT THE LAYOUT, LOCATIONS, UNIT NUMBERS AND APPROXIMATE DIMENSIONS IN SUFFICIENT DETAIL TO IDENTIFY THE COMMON ELEMENTS, LIMITED COMMON ELEMENTS AND PRIVATE ELEMENTS COMPRISING SUCH UNITS OF ADMIRALS QUARTERS CONDOMINIUM, AS BUILT.

NOTE:  
NUMBERED PARKING SPACES ARE  
LIMITED COMMON ELEMENTS.

© HENRY NORRIS & ASSOCIATES, INC.

ALABAMA REGISTRATION NUMBER 2665

DATE

Apr 21 9.0115



**HENRY  
NORRIS &  
ASSOC., INC.**

ARCHITECTURE  
&  
ENVIRONMENTAL  
DESIGN

30 N. PALAROX  
PENSACOLA,  
FLORIDA 32508

PHO 433-6401  
FAX 433-6008

**ADMIRALS QUARTERS**  
ORANGE BEACH, ALABAMA

JOB NO. 0793811  
DATE: 7/91  
CHECKED BY: [signature]  
DATE: 4/4/01  
REVISION:

SHEET

3

CONSTRUCTION  
BUSINESS RECORDS CORPORATION

**ARCHITECTURE  
&  
ENVIRONMENTAL  
DESIGN**

**(850) 432-6011**  
**FAX 435-9001**

JOB NO.: 093811  
CAD: mgil  
CHECKED: HN  
DATE: 4/4/01  
REVISION:

4

[illegible]





HENRY  
NORRIS &  
ASSOC., INC.

ARCHITECTURE  
&  
ENVIRONMENTAL  
DESIGN

30 N. PALAROX  
PENSACOLA,  
FLORIDA 32501


509 432-2000  
FAX 433-7800

ADMIRALS QUARTERS  
ORANGE BEACH, ALABAMA

JOB NO.: 072501  
CAD: mgll  
CHECKED: JH  
DATE: 4/4/01  
REVISION:

SHEET

5

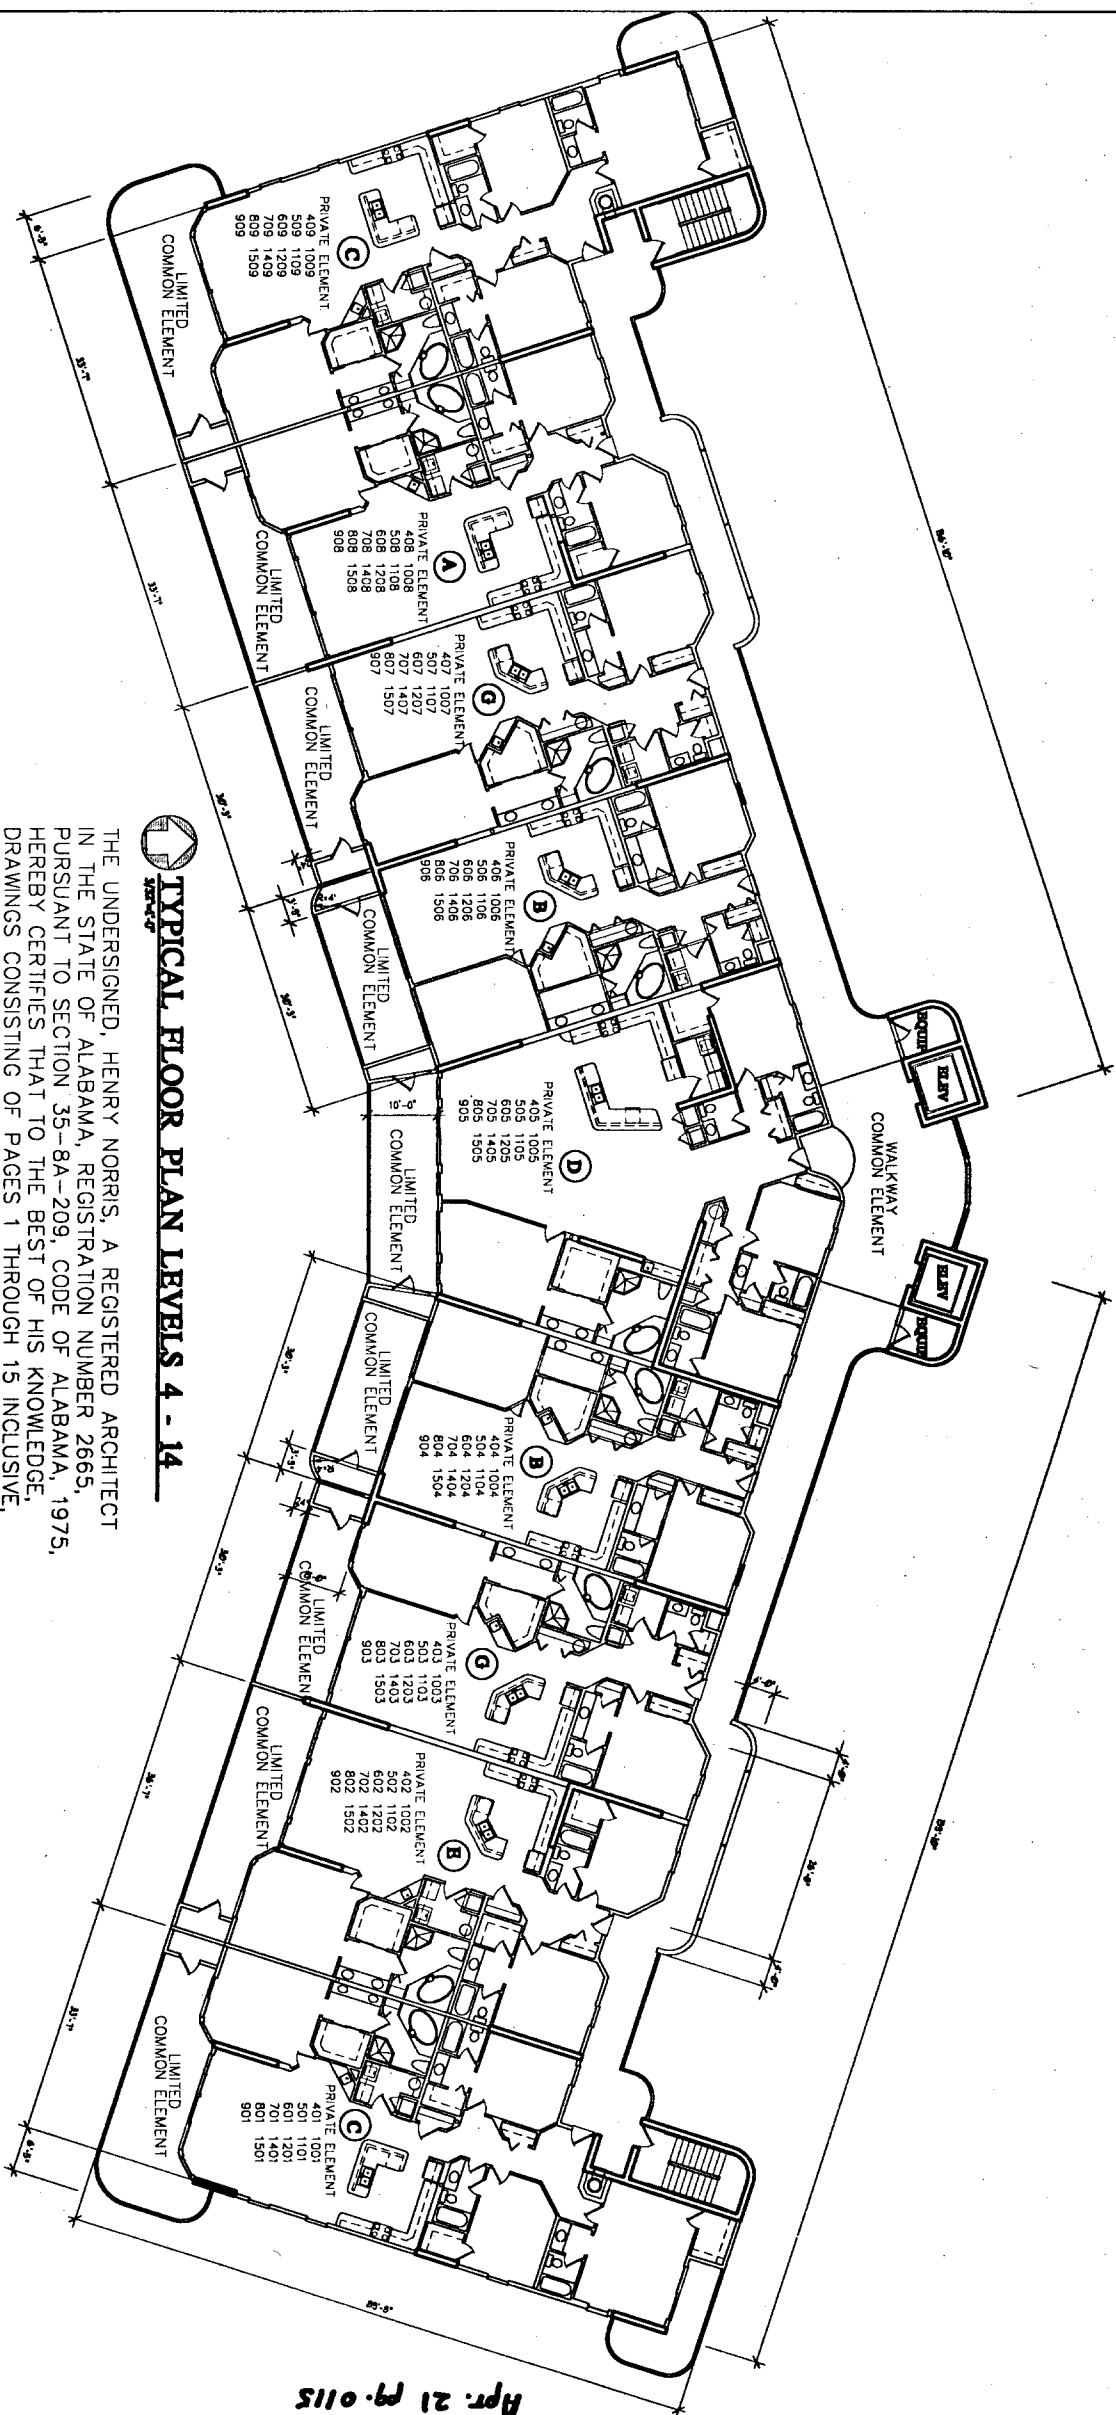

TYPICAL FLOOR PLAN LEVELS 4 - 14

THE UNDERSIGNED, HENRY NORRIS, A REGISTERED ARCHITECT IN THE STATE OF ALABAMA, REGISTRATION NUMBER 2665, PURSUANT TO SECTION 35-8A-209, CODE OF ALABAMA, 1975, HEREBY CERTIFIES THAT TO THE BEST OF HIS KNOWLEDGE, DRAWINGS CONSISTING OF PAGES 1 THROUGH 15 INCLUSIVE, ATTACHED TO AND MADE PART OF THE DECLARATION OF CONDOMINIUM OF ADMIRALS QUARTERS, A CONDOMINIUM, CONTAINS ALL INFORMATION REQUIRED BY SAID SECTION, FULLY AND ACCURATELY DEPICT THE LAYOUT, LOCATIONS, UNIT NUMBERS AND APPROXIMATE DIMENSIONS IN SUFFICIENT DETAIL TO IDENTIFY THE COMMON ELEMENTS, LIMITED COMMON ELEMENTS AND PRIVATE ELEMENTS COMPRISING SUCH UNITS OF ADMIRALS QUARTERS CONDOMINIUM, AS BUILT.


ALABAMA REGISTRATION NUMBER 2665  
DATE 4/26/01

HENRY NORRIS & ASSOCIATES, INC.


ALABAMA REGISTRATION NUMBER 2665

THE UNDERSIGNED, HENRY NORRIS, A REGISTERED ARCHITECT IN THE STATE OF ALABAMA, REGISTRATION NUMBER 2665, PURSUANT TO SECTION 35-8A-209, CODE OF ALABAMA, 1975, HEREBY CERTIFIES THAT TO THE BEST OF HIS KNOWLEDGE, DRAWINGS CONSISTING OF PAGES 1 THROUGH 15 INCLUSIVE, ATTACHED TO AND MADE PART OF THE DECLARATION OF CONDOMINIUM OF ADMIRALS QUARTERS, A CONDOMINIUM, CONTAINS ALL INFORMATION REQUIRED BY SAID SECTION, FULLY AND ACCURATELY DEPICT THE LAYOUT, LOCATIONS, UNIT NUMBERS AND APPROXIMATE DIMENSIONS IN SUFFICIENT DETAIL TO IDENTIFY THE COMMON ELEMENTS, LIMITED COMMON ELEMENTS AND PRIVATE ELEMENTS COMPRISING SUCH UNITS OF ADMIRALS QUARTERS CONDOMINIUM, AS BUILT.

*H.N.*  
ALABAMA REGISTRATION NUMBER 2665  
DATE 4/12/01

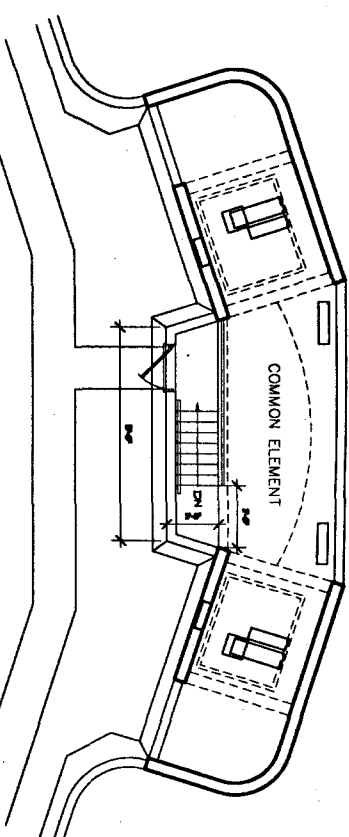

ELEVATOR EQUIPMENT ROOM PLAN

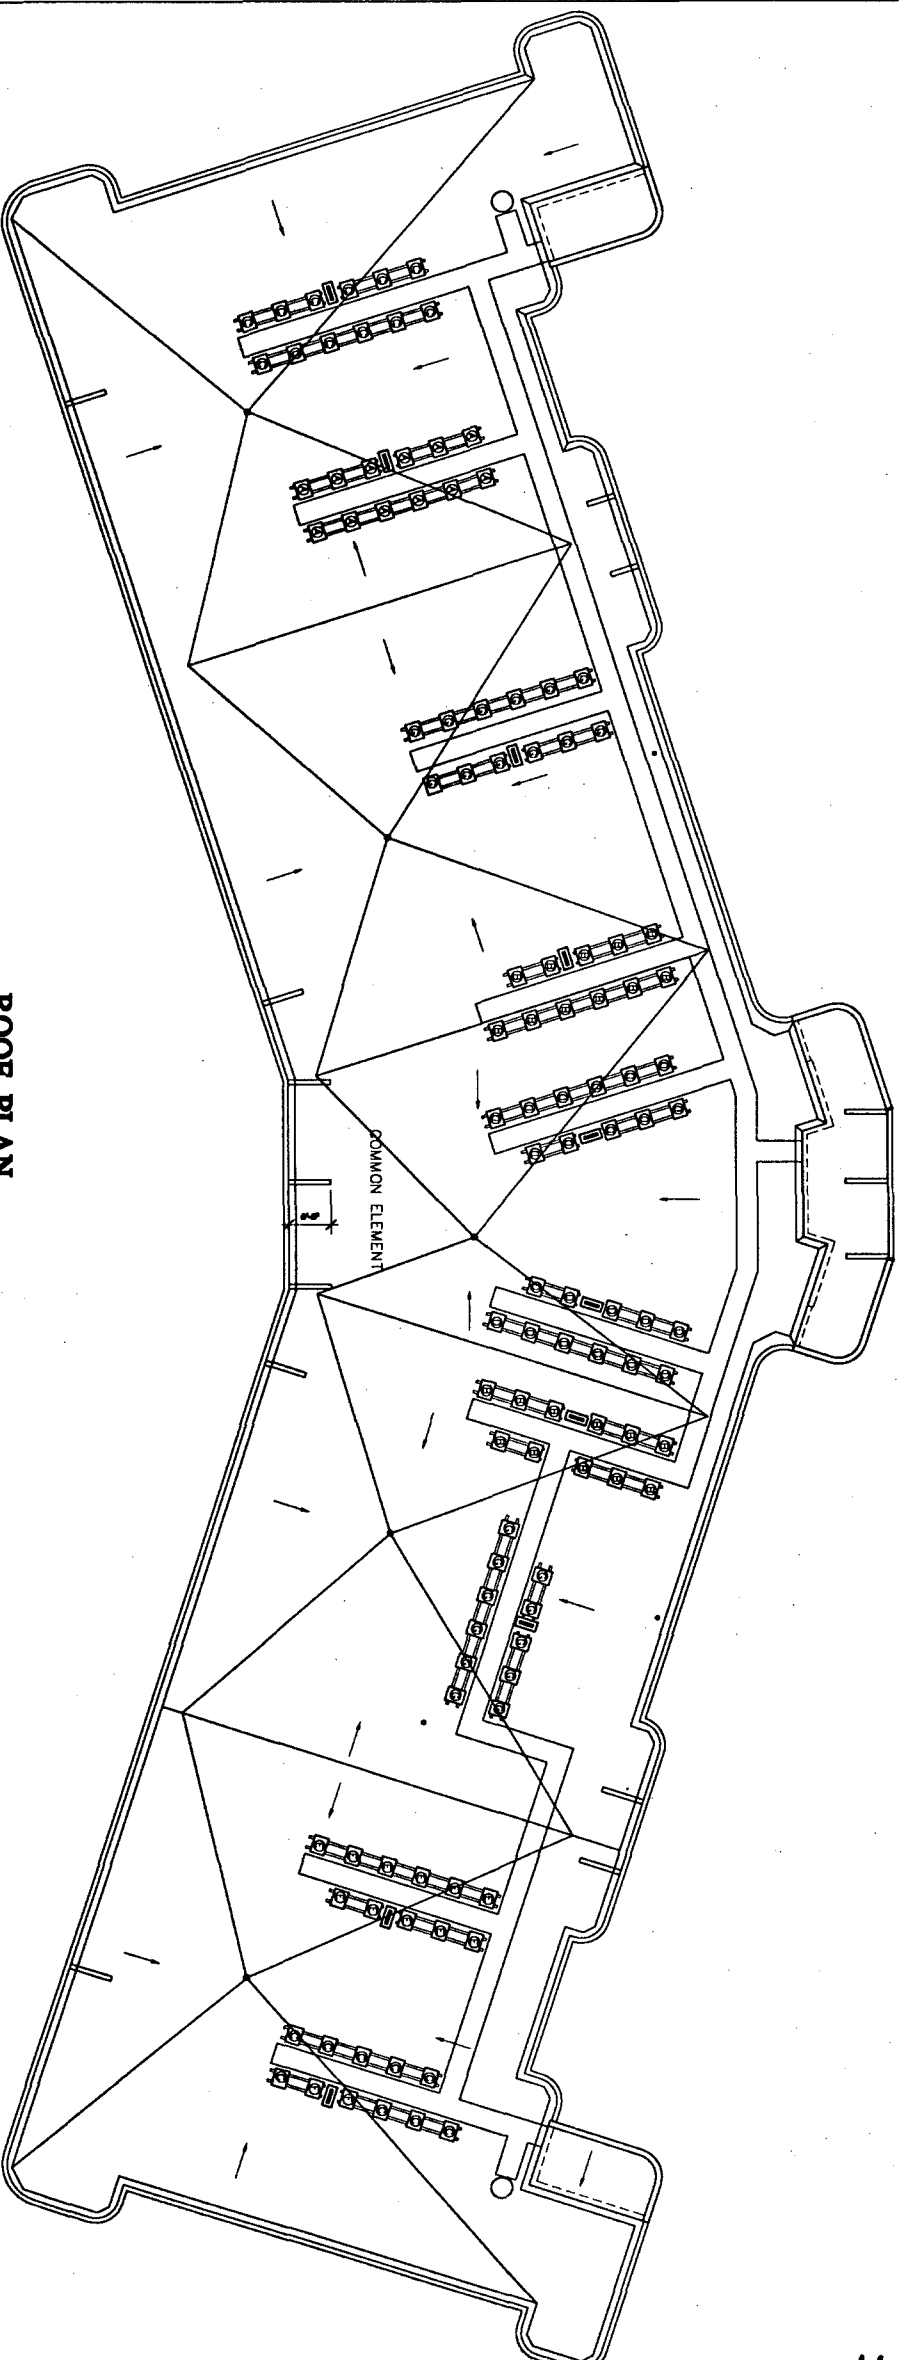

ROOF PLAN

Unrecorded 2003 Reg. No. 15

**HN**

HENRY  
NORRIS &  
ASSOC., INC.

ARCHITECTURE  
&  
ENVIRONMENTAL  
DESIGN

30 N. PALAROX  
PENSACOLA,  
FLORIDA 32501

PH: 904-433-4601  
FAX: 904-433-9020

ADMIRALS QUARTERS  
ORANGE BEACH, ALABAMA

JOB NO. 0723011  
CAD: MJI  
CHECKED: JN  
DATE: 4/4/01  
REVISION:

SHEET

6


© HENRY NORRIS & ASSOCIATES, INC.



Apr. 21 P. 0116

THE UNDERSIGNED, HENRY NORRIS, A REGISTERED ARCHITECT IN THE STATE OF ALABAMA, REGISTRATION NUMBER 2665, PURSUANT TO SECTION 35-8A-209, CODE OF ALABAMA, 1975, HEREBY CERTIFIES THAT TO THE BEST OF HIS KNOWLEDGE, DRAWINGS CONSISTING OF PAGES 1 THROUGH 15 INCLUSIVE, ATTACHED TO AND MADE PART OF THE DECLARATION OF CONDOMINIUM OF ADMIRALS QUARTERS, A CONDOMINIUM, CONTAINS ALL INFORMATION REQUIRED BY SAID SECTION, FULLY AND ACCURATELY DEPICT THE LAYOUT, LOCATIONS, UNIT NUMBERS AND APPROXIMATE DIMENSIONS IN SUFFICIENT DETAIL TO IDENTIFY THE COMMON ELEMENTS, LIMITED COMMON ELEMENTS AND PRIVATE ELEMENTS COMPRISING SUCH UNITS OF ADMIRALS QUARTERS CONDOMINIUM, AS BUILT.

ALABAMA REGISTRATION NUMBER 2665 *del* DATE *4/4/80*

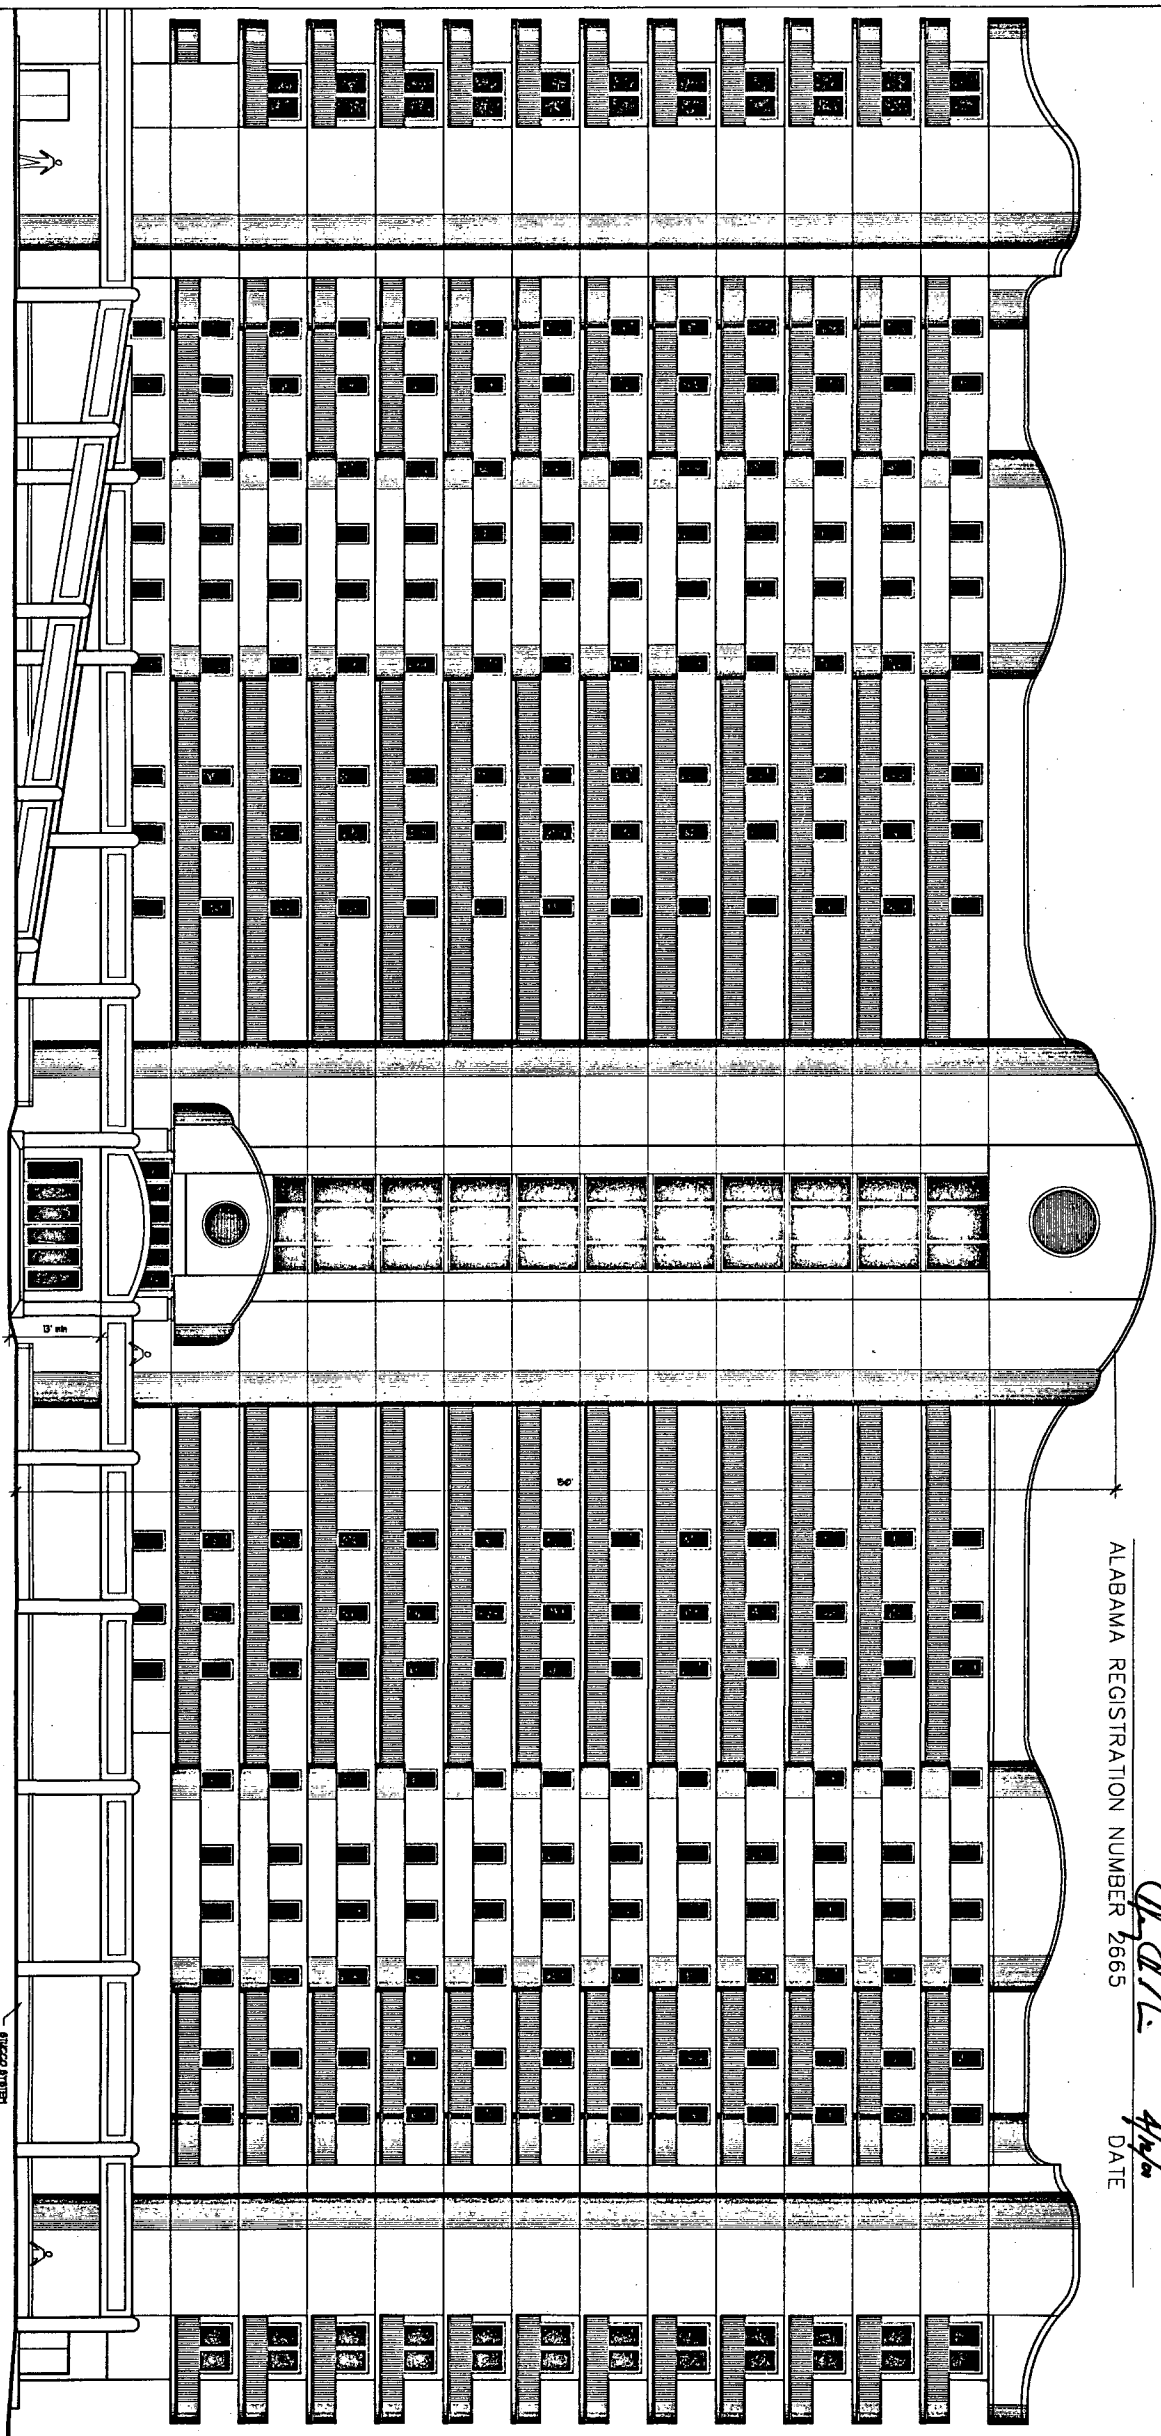

NORTH ELEVATION  
3/25-4/1/80

© HENRY NORRIS & ASSOCIATES, INC.

BUSINESS RECORDS CORPORATION

**HN**

**HENRY  
NORRIS &  
ASSOC., INC.**

ARCHITECTURE  
&  
ENVIRONMENTAL  
DESIGN

30 N. PALAFOX  
PENSACOLA,  
FLORIDA 32501

(904) 432-6811  
FAX 433-9021

*Apr. 21 P. 0117*

**ADMIRALS QUARTERS**  
**ORANGE BEACH, ALABAMA**

JOB NO.: 070381  
CAD: mgll  
CHECKED: JN  
DATE: 4/4/81  
REVISION:

SHEET

**7**

OF




THE UNDERSIGNED, HENRY NORRIS, A REGISTERED ARCHITECT IN THE STATE OF ALABAMA, REGISTRATION NUMBER 2665, PURSUANT TO SECTION 35-8A-209, CODE OF ALABAMA, 1975, HEREBY CERTIFIES THAT TO THE BEST OF HIS KNOWLEDGE, DRAWINGS CONSISTING OF PAGES 1 THROUGH 15 INCLUSIVE, ATTACHED TO AND MADE PART OF THE DECLARATION OF CONDOMINIUM OF ADMIRALS' QUARTERS, A CONDOMINIUM, CONTAINS ALL INFORMATION REQUIRED BY SAID SECTION, FULLY AND ACCURATELY DEPICT THE LAYOUT, LOCATIONS, UNIT NUMBERS AND APPROXIMATE DIMENSIONS IN SUFFICIENT DETAIL TO IDENTIFY THE COMMON ELEMENTS, LIMITED COMMON ELEMENTS AND PRIVATE ELEMENTS COMPRISING SUCH UNITS OF ADMIRALS' QUARTERS CONDOMINIUM, AS BUILT.

ALABAMA REGISTRATION NUMBER 2665

DATE

*4/2/01*

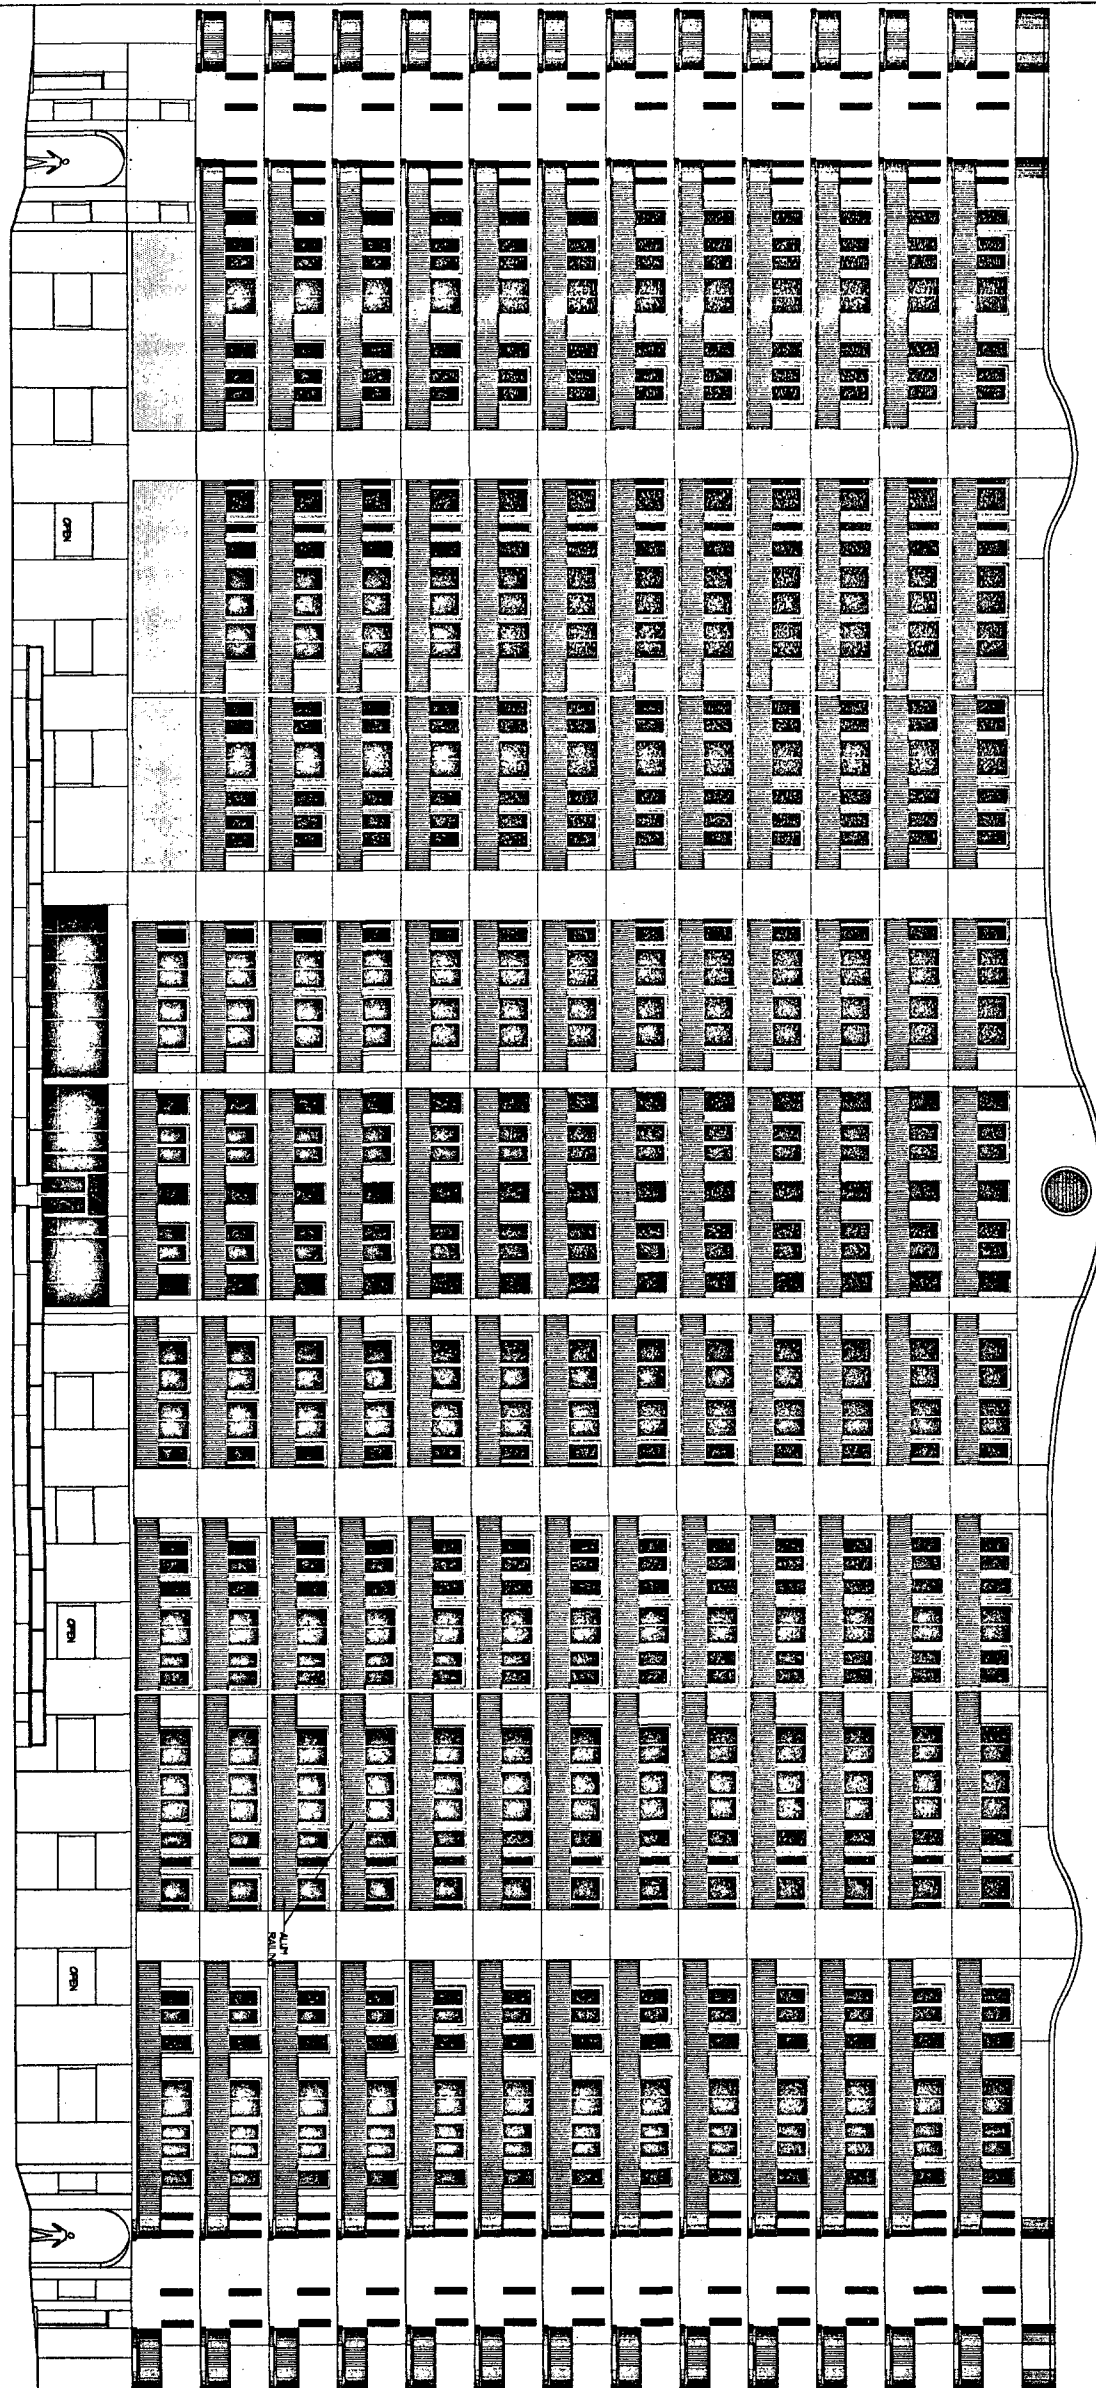

SOUTH ELEVATION

3/22-4/01

© HENRY NORRIS & ASSOCIATES, INC.

**HN**

**HENRY  
NORRIS &  
ASSOC., INC.**

ARCHITECTURE  
&  
ENVIRONMENTAL  
DESIGN

30 N. PALAROX  
PENSACOLA  
FLORIDA 32501

PRO. 03-000  
P.O. 03-000

Apr. 21 P. 0118

**ADMIRALS' QUARTERS**  
ORANGE BEACH, ALABAMA

JOB NO. 093201  
C.A.S. "GII"  
CHECKED: HN  
DATE 4/4/01  
REVISION:

SHEET

8

ALABAMA REGISTRATION NUMBER 2665

DATE 4/12/20

# Z

**HENRY  
NORRIS &  
ASSOC., INC.**

**ARCHITECTURE  
&  
ENVIRONMENTAL  
DESIGN**

30 N. PALAFOX  
PENSACOLA,  
FLORIDA 32501

(850) 432-6011  
FAX 435-9001

**ADMIRAL'S QUARTERS**  
**ORANGE BEACH, ALABAMA**

JOB NO.: 089811  
CAD: mgll  
CHECKED: HN  
DATE: 4/4/01  
REVISION:

**SHEET**

6

HENRY NORRIS & ASSOCIATES, INC.


### EAST ELEVATION

0 1 2 3 4 5 6

Business Records Corporation

THE UNDERSIGNED, HENRY NORRIS, A REGISTERED ARCHITECT IN THE STATE OF ALABAMA, REGISTRATION NUMBER 2665, PURSUANT TO SECTION 35-8A-209, CODE OF ALABAMA, 1975, HEREBY CERTIFIES THAT TO THE BEST OF HIS KNOWLEDGE, DRAWINGS CONSISTING OF PAGES 1 THROUGH 15 INCLUSIVE, ATTACHED TO AND MADE PART OF THE DECLARATION OF CONDOMINIUM OF ADMIRALS QUARTERS, A CONDOMINIUM, CONTAINS ALL INFORMATION REQUIRED BY SAID SECTION, FULLY AND ACCURATELY DEPICT THE LAYOUT, LOCATIONS, UNIT NUMBERS AND APPROXIMATE DIMENSIONS IN SUFFICIENT DETAIL TO IDENTIFY THE COMMON ELEMENTS, LIMITED COMMON ELEMENTS AND PRIVATE ELEMENTS COMPRISING SUCH UNITS OF ADMIRALS QUARTERS CONDOMINIUM, AS BUILT.

*Ad. L.* *4/19/91*  
ALABAMA REGISTRATION NUMBER 2665 DATE

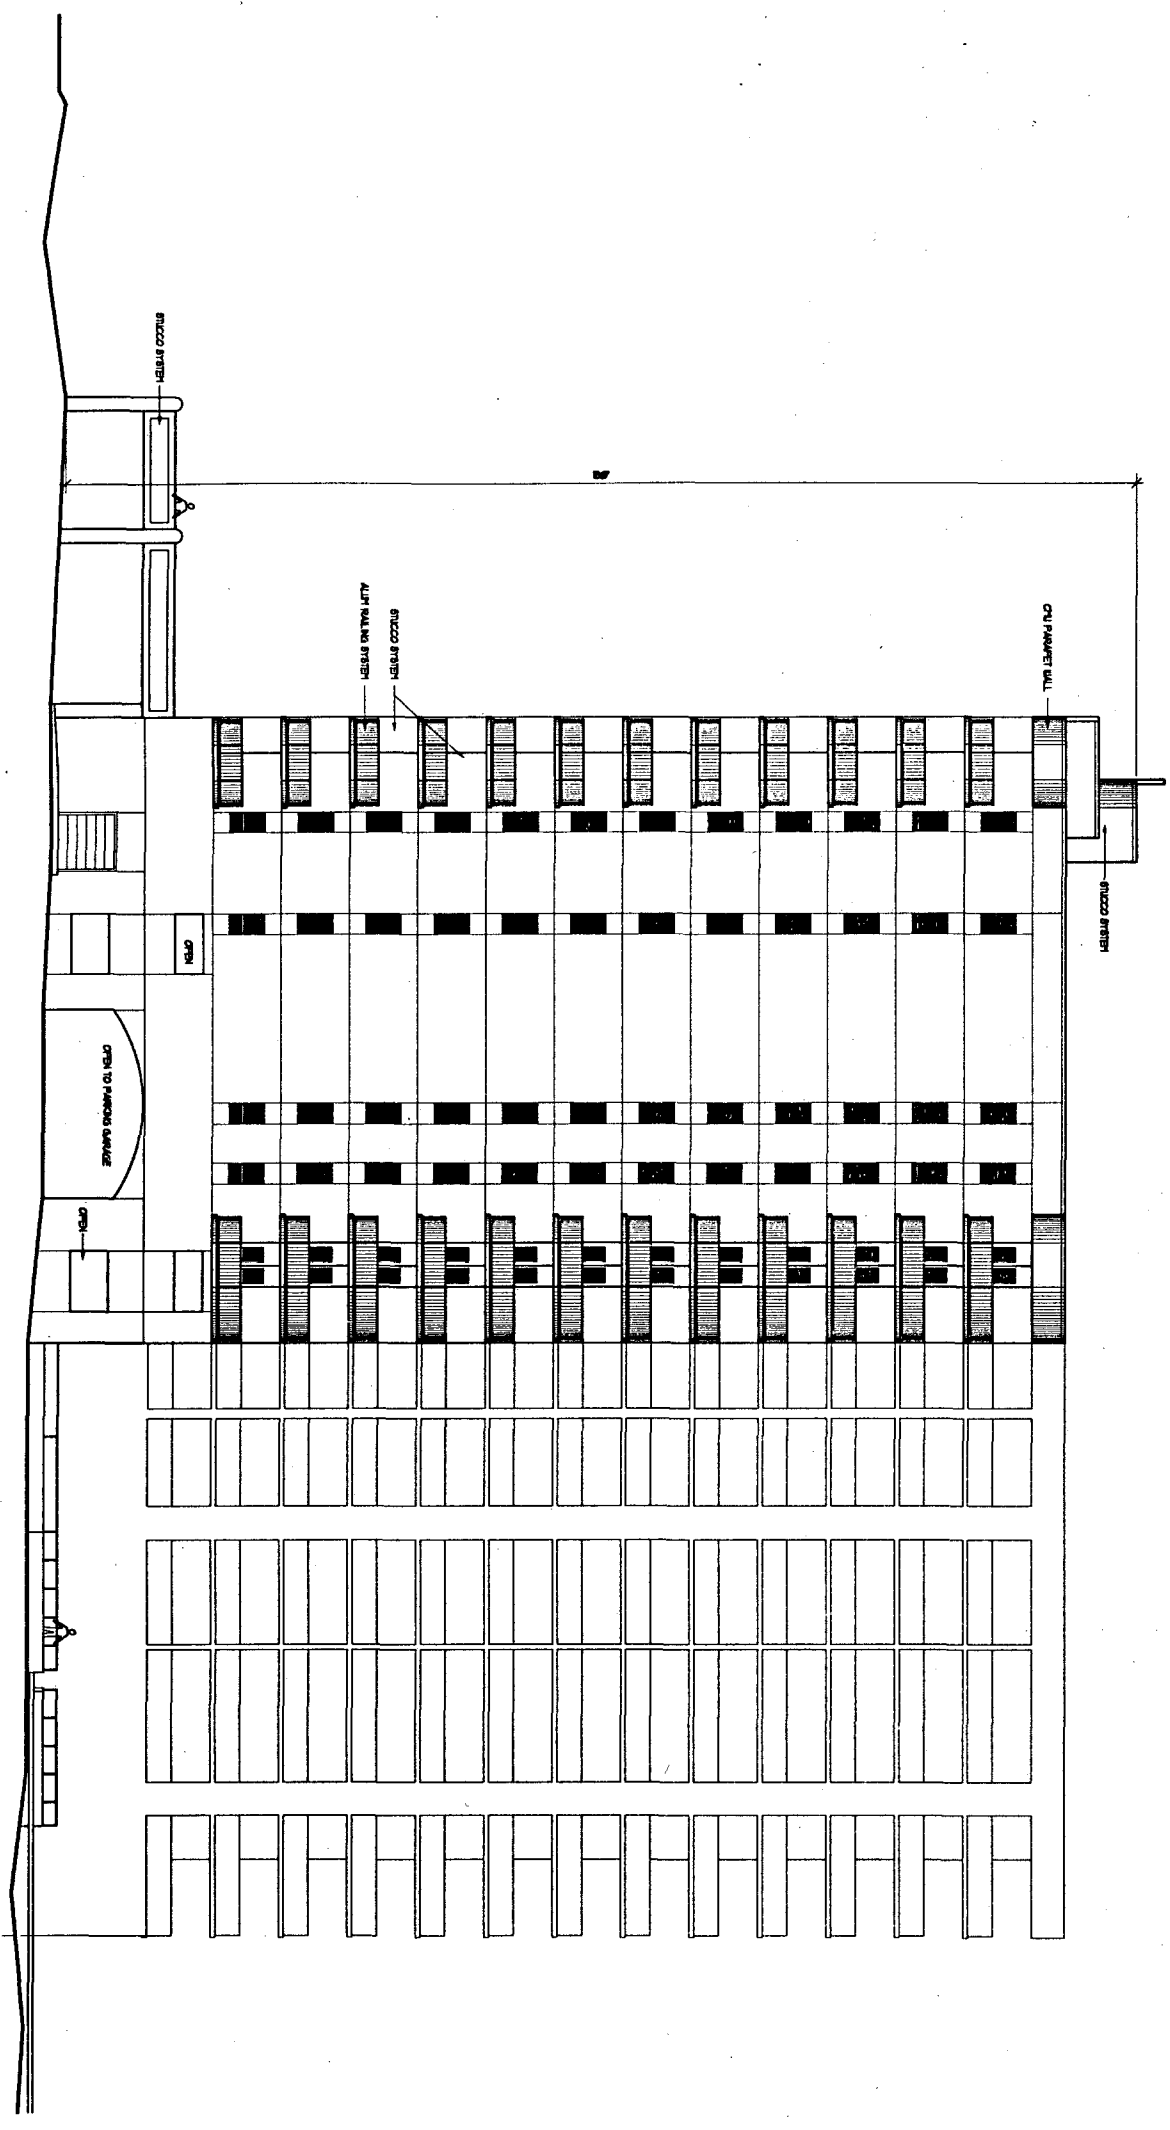

WEST ELEVATION  
3/22/91-UP

© HENRY NORRIS & ASSOCIATES, INC.

UNIVERSITY MICROFILMS  
SERIALS ACQUISITION  
300 N. ZEEB RD.  
ANN ARBOR MI 48106-1500

Apr 21 P. 0120

**HN**

**HENRY  
NORRIS &  
ASSOC., INC.**

ARCHITECTURE  
&  
ENVIRONMENTAL  
DESIGN

30 N. PALAROX  
PENSACOLA,  
FLORIDA 32501


(904) 432-6001  
FAX 433-5001

**ADMIRALS QUARTERS**  
ORANGE BEACH, ALABAMA

JOB NO.: 079601  
CAD: ngil  
CHECKED: IN  
DATE: 4/4/91  
REVISION:

SHEET


10

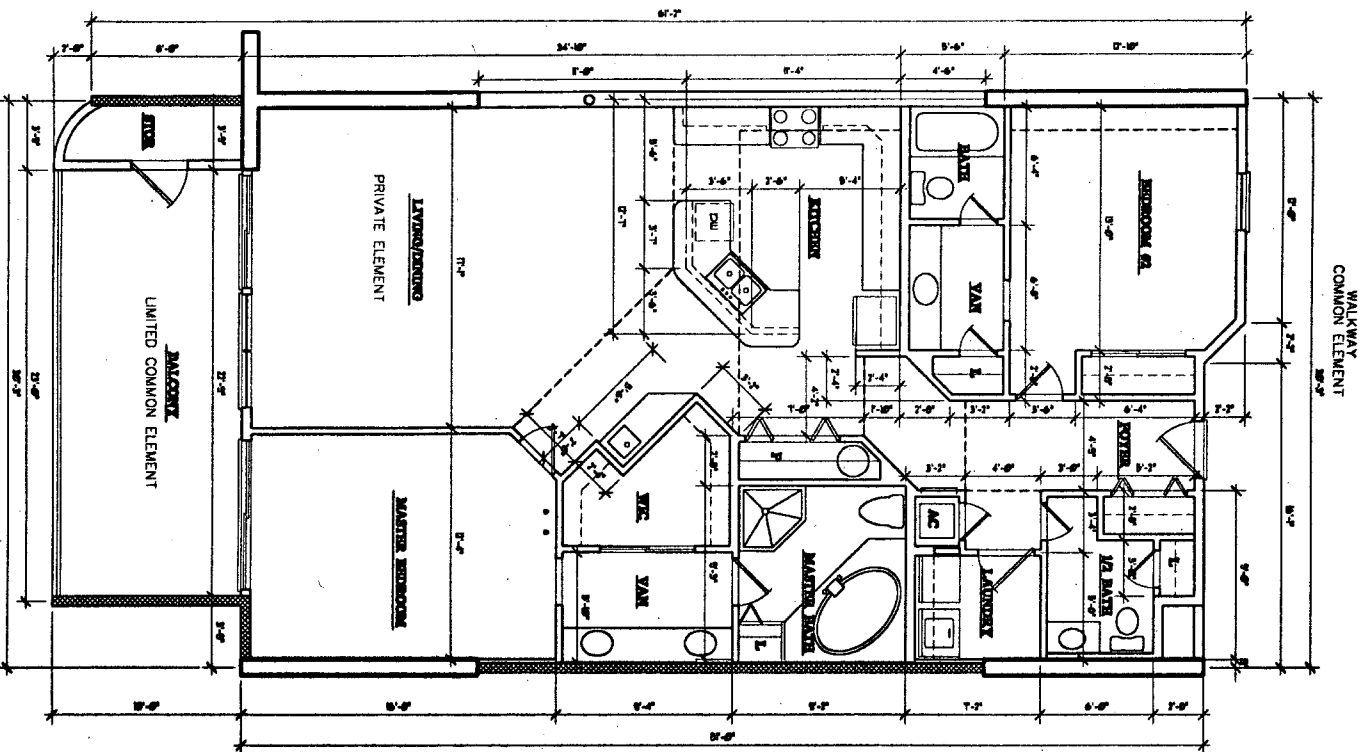

TYPICAL FLOOR PLAN UNIT B  
1/4"=1'-0"  
47-1087 B

THE UNDERSIGNED, HENRY NORRIS, A REGISTERED ARCHITECT IN THE STATE OF ALABAMA, REGISTRATION NUMBER 2665, PURSUANT TO SECTION 35-8A-209, CODE OF ALABAMA, 1975, HEREBY CERTIFIES THAT TO THE BEST OF HIS KNOWLEDGE, DRAWINGS CONSISTING OF PAGES 1 THROUGH 15 INCLUSIVE, ATTACHED TO AND MADE PART OF THE DECLARATION OF CONDOMINIUM OF ADMIRALS QUARTERS, A CONDOMINIUM, CONTAINS ALL INFORMATION REQUIRED BY SAID SECTION, FULLY AND ACCURATELY DEPICT THE LAYOUT, LOCATIONS, UNIT NUMBERS AND APPROXIMATE DIMENSIONS IN SUFFICIENT DETAIL TO IDENTIFY THE COMMON ELEMENTS, LIMITED COMMON ELEMENTS AND PRIVATE ELEMENTS COMPRISING SUCH UNITS OF ADMIRALS QUARTERS CONDOMINIUM AS BUILT.

ALABAMA REGISTRATION NUMBER 2665  
*Henry Norris*  
DATE 4/12/01

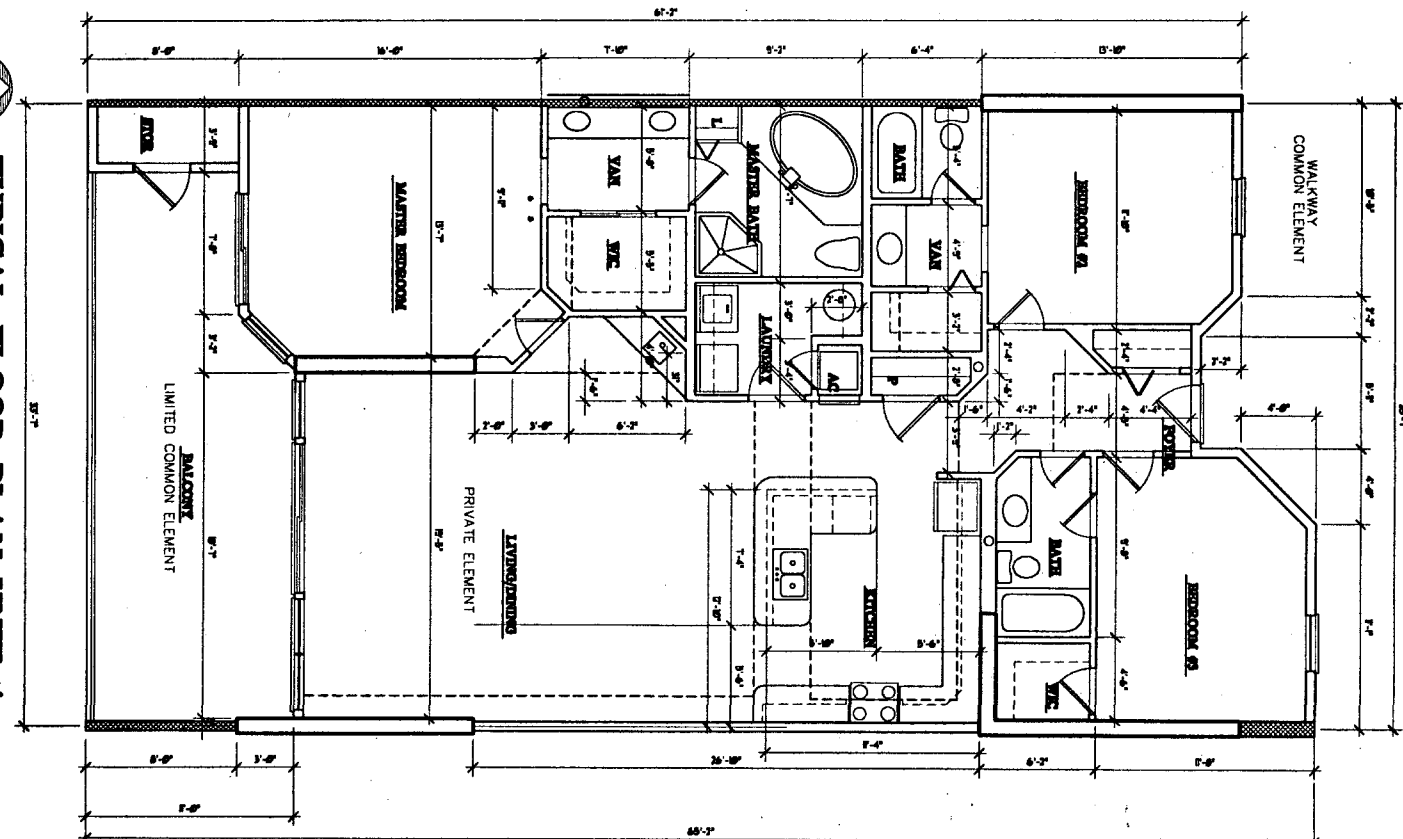

TYPICAL FLOOR PLAN UNIT A  
1/4"=1'-0"  
47-1087 A

Apr. 21 19. 0121



HENRY  
NORRIS &  
ASSOC., INC.

ARCHITECTURE  
&  
ENVIRONMENTAL  
DESIGN

30 N. PALM  
PENSACOLA,  
FLORIDA 32501

(904) 433-6011  
FAX 433-6001

ADMIRALS QUARTERS  
ORANGE BEACH, ALABAMA

JOB NO. 093611  
DATE mgj  
CHECKED LN  
DATE 4/4/01  
REVISION

SHEET

11



HENRY  
NORRIS &  
ASSOC., INC.

ARCHITECTURE  
&  
ENVIRONMENTAL  
DESIGN

30 N. PALAFOX  
PENSACOLA,  
FLORIDA 32501

850 433-4411  
FAX 433-4401


ADMIRALS QUARTERS  
ORANGE BEACH, ALABAMA

JOB NO. 093811  
CAD: mg1  
CHECKED: IN  
DATE: 4/4/01  
REVISION:

12


SHEET

Apr 21 M. 0122

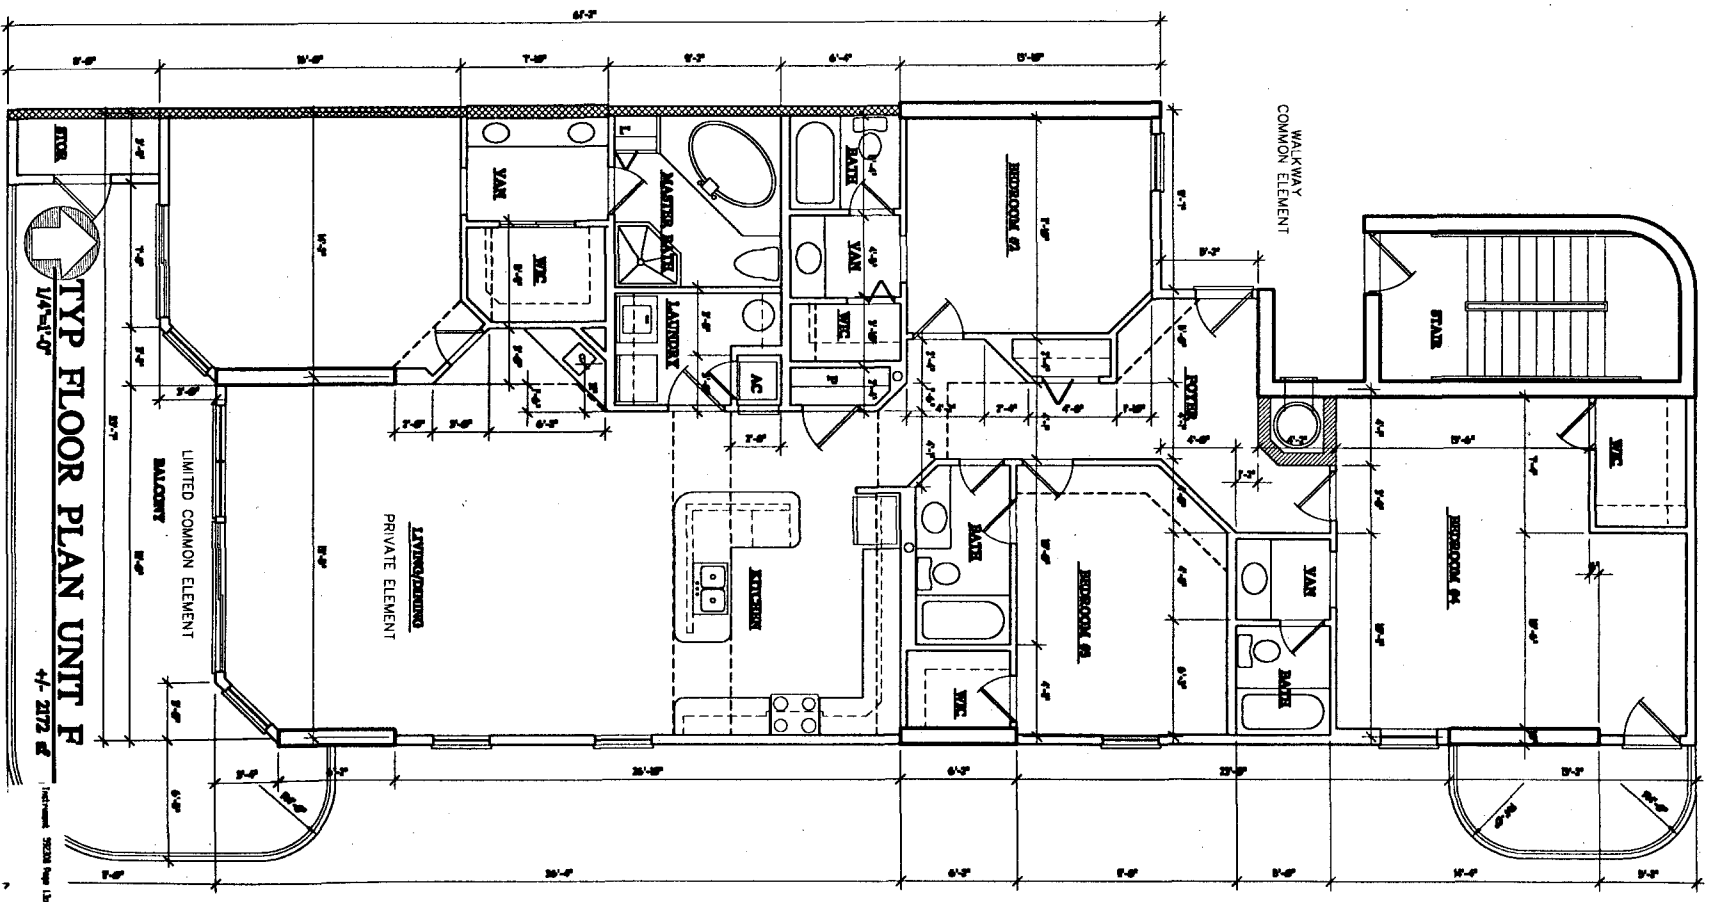

THE UNDERSIGNED, HENRY NORRIS, A REGISTERED ARCHITECT IN THE STATE OF ALABAMA, REGISTRATION NUMBER 2665, PURSUANT TO SECTION 35-8A-209, CODE OF ALABAMA, 1975, HEREBY CERTIFIES THAT TO THE BEST OF HIS KNOWLEDGE, DRAWINGS CONSISTING OF PAGES 1 THROUGH 15 INCLUSIVE, ATTACHED TO AND MADE PART OF THE DECLARATION OF CONDOMINIUM OF ADMIRALS QUARTERS, A CONDOMINIUM, CONTAINS ALL INFORMATION REQUIRED BY SAID SECTION, FULLY AND ACCURATELY DEPICT THE LAYOUT, LOCATIONS, UNIT NUMBERS AND APPROXIMATE DIMENSIONS IN SUFFICIENT DETAIL TO IDENTIFY THE COMMON ELEMENTS, LIMITED COMMON ELEMENTS AND PRIVATE ELEMENTS COMPRISING SUCH UNITS OF ADMIRALS QUARTERS CONDOMINIUM, AS BUILT.

*D. D. L.* 4/14/01  
ALABAMA REGISTRATION NUMBER 2665 DATE

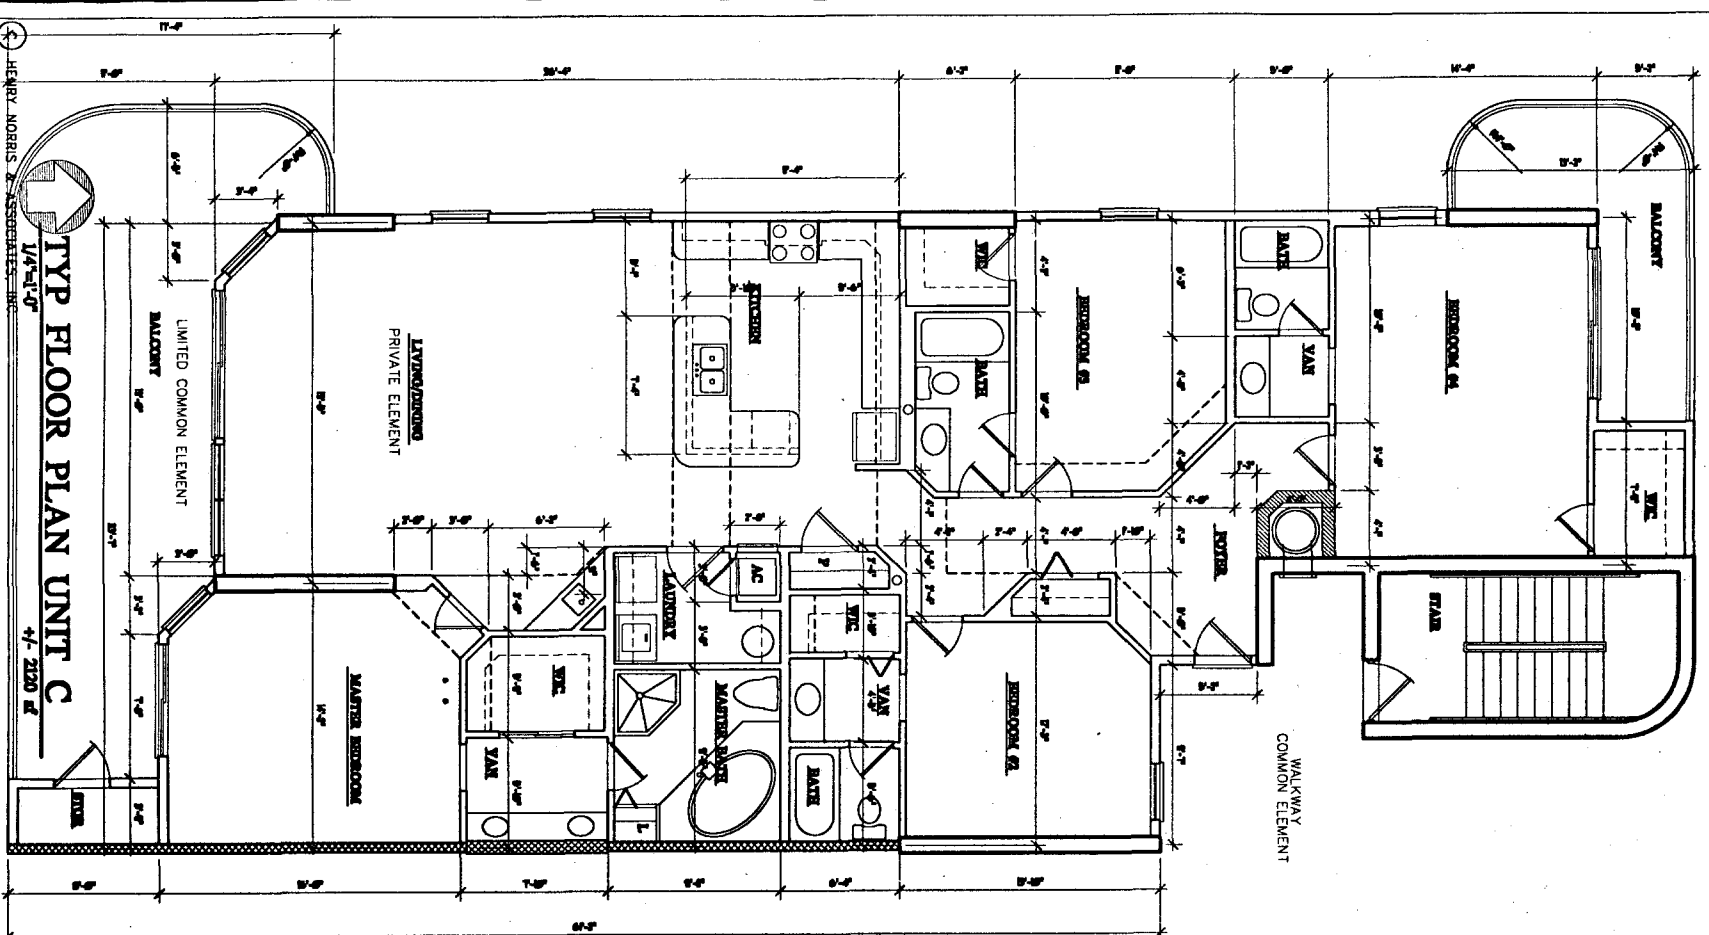


CONTROLLED DOCUMENT  
UNLESS INDICATED OTHERWISE  
BUSINESS RECORDS CORPORATION



THE UNDERSIGNED, HENRY NORRIS, A REGISTERED ARCHITECT IN THE STATE OF ALABAMA, REGISTRATION NUMBER 2665, HEREBY CERTIFIES THAT TO THE BEST OF HIS KNOWLEDGE, DRAWINGS CONSISTING OF PAGES 1 THROUGH 15 INCLUSIVE, ATTACHED TO AND MADE PART OF THE DECLARATION OF CONDOMINIUM OF ADMIRALS QUARTERS, A CONDO SECTION, CONTAINS ALL INFORMATION REQUIRED BY SAID DECLARATION, FULLY AND ACCURATELY DEPICT THE LAYOUT, LOCATIONS, UNIT NUMBERS AND APPROXIMATE DIMENSIONS IN SUFFICIENT DETAIL TO IDENTIFY THE COMMON ELEMENTS LIMITED COMMON ELEMENTS AND PRIVATE ELEMENTS COMPRISING SUCH UNITS OF ADMIRALS QUARTERS CONDOMINIUM, AS BUILT.

*Handwritten:* 2665 4/14/01  
ALABAMA REGISTRATION NUMBER 2665 DATE

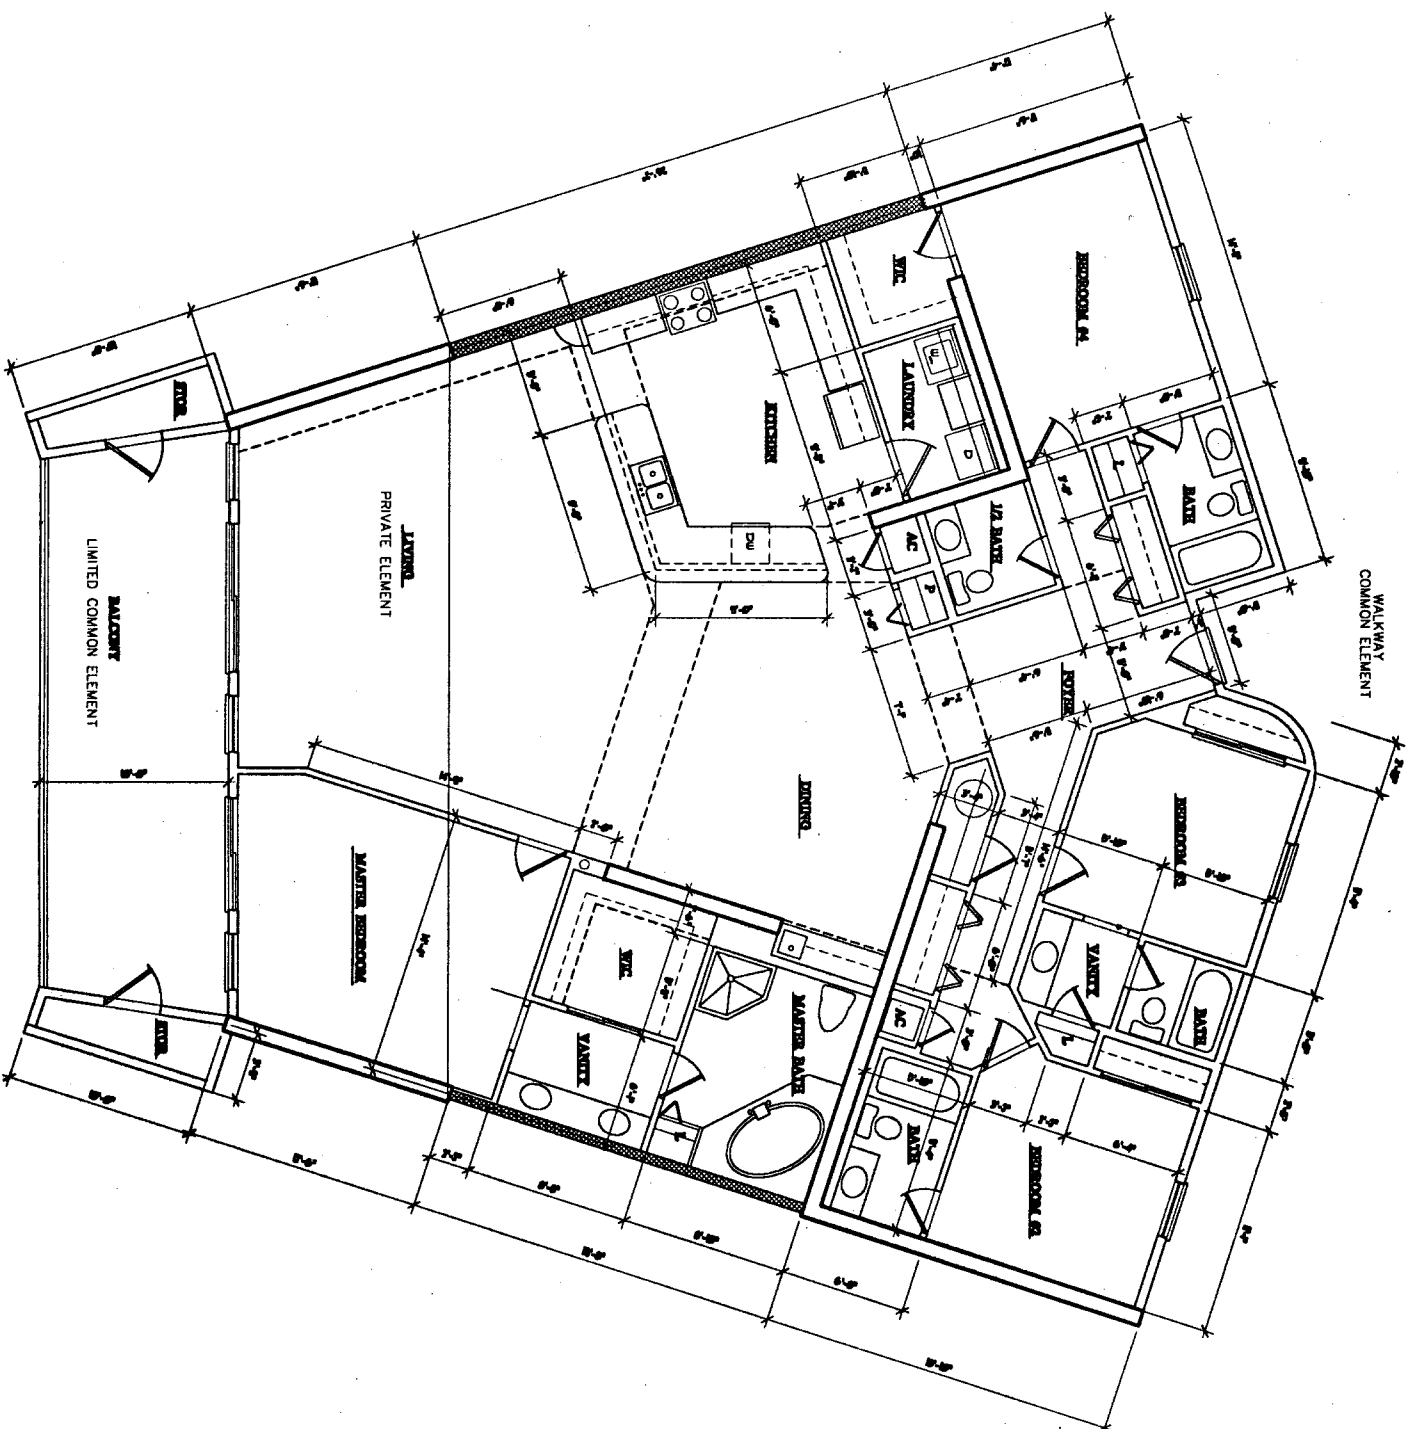

 TYPICAL FLOOR PLAN UNIT D  
1/4" = 1'-0"  
47-2301-2

© HENRY NORRIS & ASSOCIATES, INC.

REVISIONS  
DATE  
BY  
CHECKED  
DATE  
BY

Apr. 21 P9. 0123


ADMIRALS QUARTERS  
ORANGE BEACH, ALABAMA

JOB NO. 099311  
CAD. mg  
CHECKED. JN  
DATE 4/4/01  
REVISION

**HN**  
HENRY  
NORRIS &  
ASSOC., INC.  
ARCHITECTURE  
&  
ENVIRONMENTAL  
DESIGN  
30 N. PALATKA  
PENSACOLA,  
FLORIDA 32501  
(904) 433-4011  
FAX 433-9011

SHEET

13

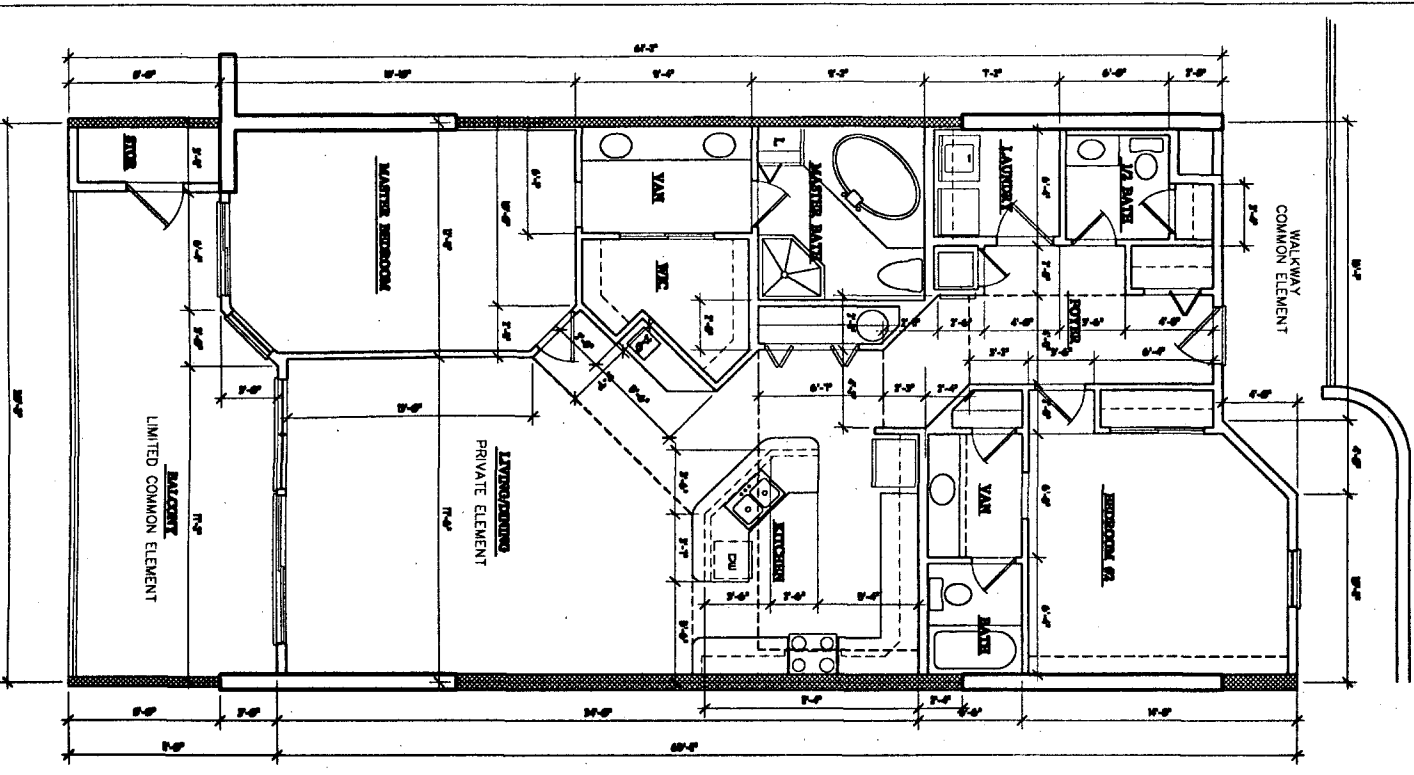


**TYPICAL FLOOR PLAN UNIT G**  
1/4"=1'-0"

© HENRY NORRIS & ASSOCIATES, INC.

THE UNDERSIGNED, HENRY NORRIS, A REGISTERED ARCHITECT IN THE STATE OF ALABAMA, REGISTRATION NUMBER 2665, PURSUANT TO SECTION 35-8A-209, CODE OF ALABAMA, 1975, HEREBY CERTIFIES THAT TO THE BEST OF HIS KNOWLEDGE, DRAWINGS CONSISTING OF PAGES 1 THROUGH 15 INCLUSIVE, ATTACHED TO AND MADE PART OF THE DECLARATION OF CONDOMINIUM OF ADMIRALS QUARTERS, A CONDOMINIUM, CONTAINS ALL INFORMATION REQUIRED BY SAID SECTION, FULLY AND ACCURATELY DEPICT THE LAYOUT, LOCATIONS, UNIT NUMBERS AND APPROXIMATE DIMENSIONS IN SUFFICIENT DETAIL TO IDENTIFY THE COMMON ELEMENTS, LIMITED COMMON ELEMENTS AND PRIVATE ELEMENTS COMPRISING SUCH UNITS OF ADMIRALS QUARTERS CONDOMINIUM, AS BUILT.

*D.d.L.* DATE *4/9/04*  
ALABAMA REGISTRATION NUMBER 2665

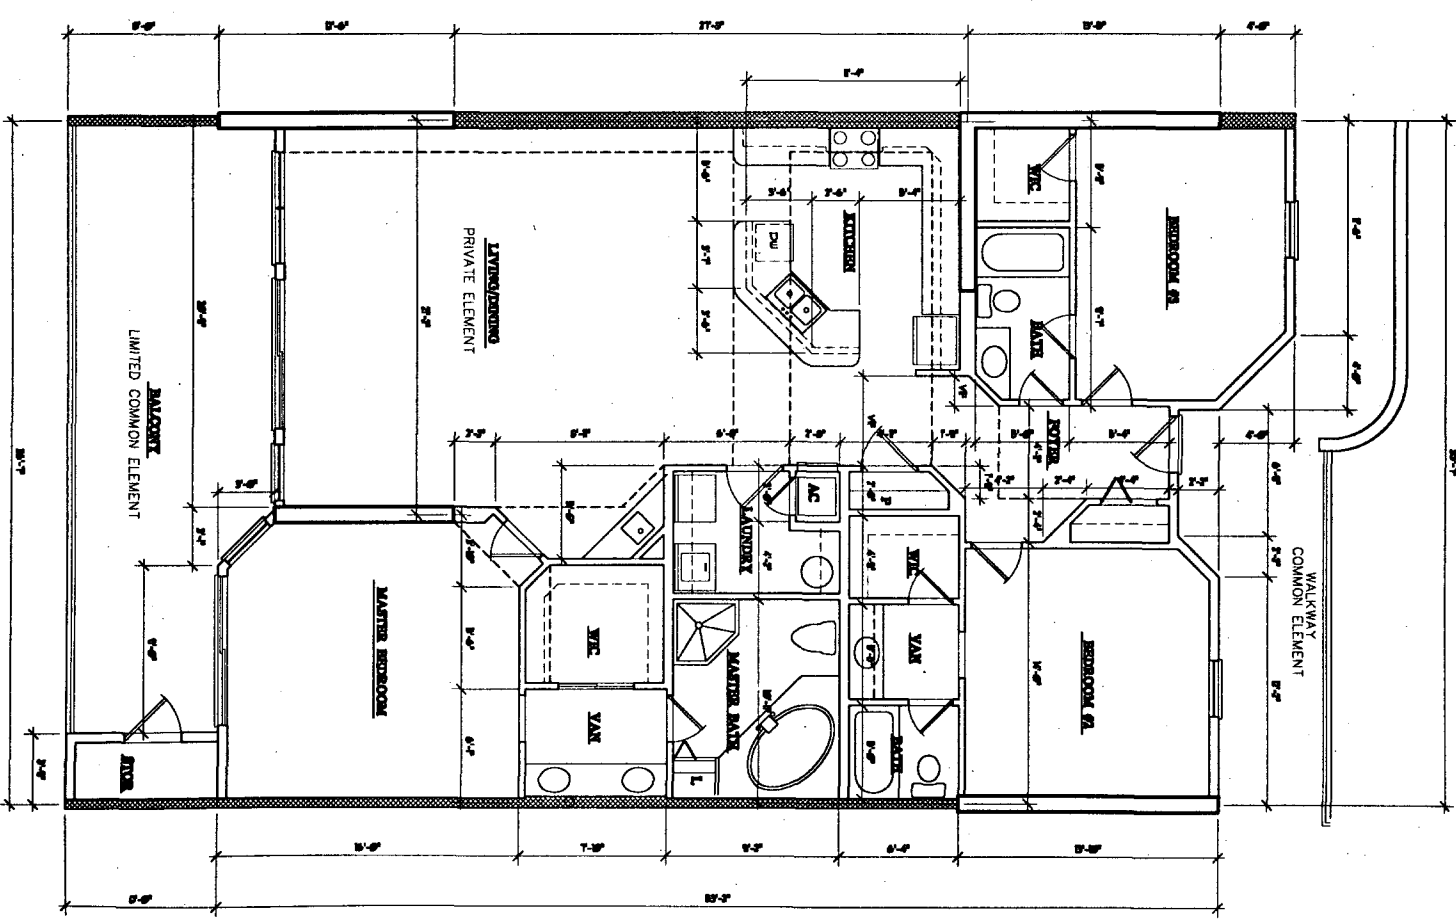

**TYPICAL FLOOR PLAN UNIT E**  
1/4"=1'-0"

1/4"=1'-0" SECTION SCALE 1/4"=1'-0"

*Apr 21 09.0124*




**HENRY  
NORRIS &  
ASSOC., INC.**  
ARCHITECTURE  
&  
ENVIRONMENTAL  
DESIGN

30 N. PALMBOX  
PENSACOLA,  
FLORIDA 32501  
(904) 433-8001  
FAX 433-9001

**ADMIRALS QUARTERS**  
ORANGE BEACH, ALABAMA

JOB NO. 0793011  
CAD. mgj  
CHECKED IN  
DATE 4/4/01  
REVISION

SHEET  
**14**

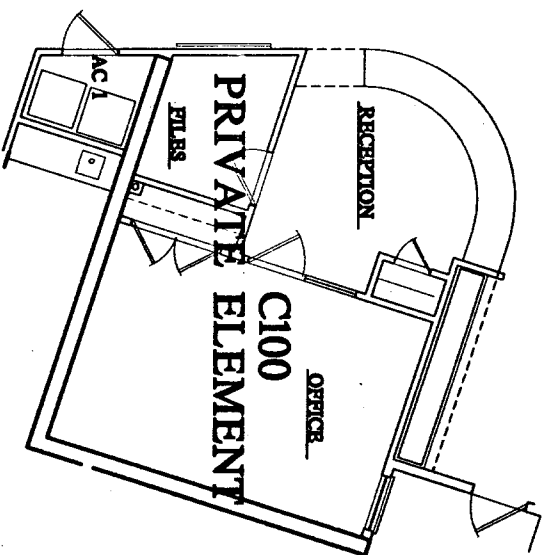

**COMMERCIAL UNIT**  
496sqft

THE UNDERSIGNED, HENRY NORRIS, A REGISTERED ARCHITECT IN THE STATE OF ALABAMA, REGISTRATION NUMBER 2665, PURSUANT TO SECTION 35-8A-209, CODE OF ALABAMA, 1975, HEREBY CERTIFIES THAT TO THE BEST OF HIS KNOWLEDGE, DRAWINGS CONSISTING OF PAGES 1 THROUGH 15 INCLUSIVE, ATTACHED TO AND MADE PART OF THE DECLARATION OF CONDOMINIUM OF ADMIRALS QUARTERS, A CONDOMINIUM, CONTAINS ALL INFORMATION REQUIRED BY SAID SECTION, FULLY AND ACCURATELY DEPICT THE LAYOUT, LOCATIONS, UNIT TO BEBEN AND APPROXIMATE DIMENSIONS IN SUFFICIENT DETAIL TO IDENTIFY THE COMMON ELEMENTS, LIMITED COMMON ELEMENTS AND PRIVATE ELEMENTS COMPRISING SUCH UNITS OF ADMIRALS QUARTERS CONDOMINIUM, AS BUILT.

*QNL*  
DATE *4/4/01*

ALABAMA REGISTRATION NUMBER 2665

Apr. 21 P. 0125



**HENRY  
NORRIS &  
ASSOC., INC.**  
ARCHITECTURE  
&  
ENVIRONMENTAL  
DESIGN

30 N. PALAROX  
PENSACOLA,  
FLORIDA 32501

(904) 432-2411  
FAX 432-2001

**ADMIRALS QUARTERS**  
ORANGE BEACH, ALABAMA

JOB NO. 079241  
DATE: 4/11  
CHECKED: JN  
DATE: 4/4/01  
REVISION:

SHEET

15